

MISSISSIPPI DEPARTMENT OF ENVIRONMENTAL QUALITY

Office of Land and Water Resources

P. O. Box 10631
Jackson, MS 39289-0631
WATER WELL DRILLERS LOG

COUNTY WELL LOCATED LINCOLN	
WELL NUMBER H 2085	CODED
DATE WELL COMPLETED Oct 23-93	

PERMIT NUMBER
NAME OF DRILLING FIRM Fitzgerald Well Serv

NAME & MAILING ADDRESS OF LANDOWNER LAMAR WALLS		
PO Box Brookhaven ms.		
WELL LOCATION: SEC <u>30</u> TOWNSHIP <u>7</u> N RANGE <u>8</u> E W		
DISTANCE <u>1</u> Miles <u>S</u> DIRECTION of <u>Brookhaven</u> NEAREST TOWN		
OTHER LANDMARK		
WELL PURPOSE: Home, Irrigation, Municipal, Industrial, Fish Pond, etc. Home		

PUMP DATA		
PUMP TYPE (Circle One): Submersible , Turbine, Jet, Flowing Well, Other (Describe)		
POWER TYPE (Circle One): <u>Electric</u> , Tractor, Diesel, Gasoline, Butane, Other (Describe) <u>H/P 1/2</u>		
Pump Capacity (GPM) 10	No. of Stages 8	Setting Depth 90 FT.
PUMP TEST		
Well yielded <u>20</u> GPM with a drawdown of <u>2</u> ft. after <u>2</u> hours of pumping		

WELL DATA		
Well Depth 105	Casing Diameter (In.) 4	Casing Length (Ft.) 95
Type of Casing PVC	Hole Depth 105	Depth to Static Water Level 46
TYPE OF COMPLETION: (Circle One or More): <u>Gravel Packed</u> , Underreamed, Telescoped, Natural Development, Open Hole, Other (Describe)		
WELL GROUTED TO A DEPTH OF <u>10</u> FEET Type Grout (circle one): Cement, Bentonite, or <u>Mix</u>		

LOG DATA	
TYPE OF LOG RUN (Circle One): Electric, Gamma Ray, Density, Sonic, <u>No Log Run</u> , Neutron, Other (Describe)	
Name of Organization Running Log	

GEOLOGIC DATA (Office Use Only)			
Surface Elev.	Geologic Unit	Unit Thickness	Depth to Top
Subs. SWL	Date	Analysis	Aquifer Test
Driller's Remarks			

SCREEN DATA		
Diameter - Inches 4	Length - Feet 10	Slot Size - Inches 1014
Screen Type PVC		Depth to Bottom - Feet 105


DESCRIPTION OF FORMATIONS ENCOUNTERED	FROM	TO	FORMATIONS (Continued)	FROM	TO
Red Clay	0	20	RECEIVED	JAN 05 1994	
Red Sand	20	91			
Coarse Sand & Gravel	91	105			

Dept. of Environmental Quality
Office of Land & Water Resources

IF MORE SPACE IS NEEDED, USE BACK

If well telescopes please sketch and show depths.

GROUND LEVEL

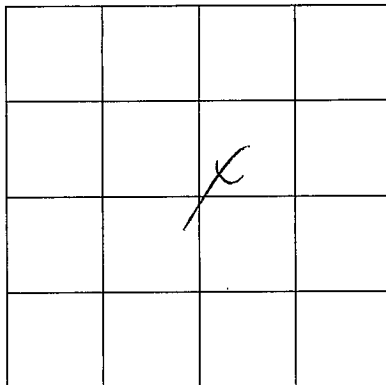

SECTION 30

Please indicate well location X.

ADDITIONAL INFORMATION

If more than one screen,
show location of each on sketch.