

LINCOLN
H 2087

MISSISSIPPI
BOARD OF WATER COMMISSIONERS
416 North State Street
Jackson, Mississippi 39201

WATER WELL DRILLERS LOG

MAR 21 1994 Fillzgernd well serv LINCOLN
date well completed firm name county well located

LANDOWNER:
Best Canals
R.R. Brookman, Jr.
(mailing address)

description of formations encountered	from	to
<u>Red clay</u>	<u>2</u>	<u>10</u>
<u>white clay</u>	<u>10</u>	<u>105</u>
<u>Common Sand</u>	<u>105</u>	<u>120</u>

WELL LOCATION:
sec. 30 T. 2 N R. 3 E
S W
1 miles South of Brookman
(distance) (direction) (nearest town)

WELL PURPOSE: Home
(home, irrigation, municipal, industrial)

- WELL COMPLETION DATA:
- (1) diameter (inches) 4
 - (2) total depth (feet) 120
 - (3) static water level (feet) 35 below above top of ground.
 - (4) casing MC 110
(material) (depth)
4 if telescope see back.
(size)
 - (5) screen 10 110
(length) (depth to top)
4 MC
(size) (material)
 - (6) pump 1/2 10
(HP) (yield gpm)
El
(type power)
 - (7) electric log No
(yes or no)
(organization running log)
 - (8) how well bottom plugged Sealed

DRILLERS REMARKS:


RECEIVED

JUN 17 1994

Dept. of Environmental Quality
Office of Land & Water Resources

If well telescopes please sketch and show depths.

GROUND LEVEL

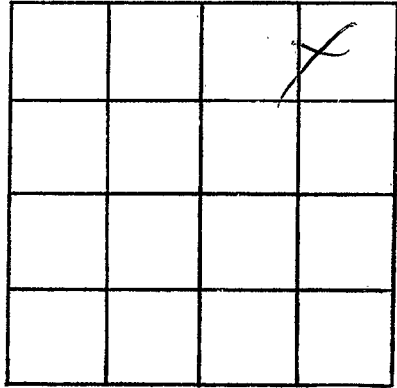

SECTION 30

Please indicate well location X.

ADDITIONAL INFORMATION

A series of horizontal lines provided for entering additional information.

If more than one screen, show locations of each on sketch.