

Lincoln  
H 2088

MISSISSIPPI  
BOARD OF WATER COMMISSIONERS  
416 North State Street  
Jackson, Mississippi 39201

WATER WELL DRILLERS LOG

MAR 23 1994 Fitzgerald Well Service Lincoln  
date well completed firm name county well located

LANDOWNER:	description of formations encountered	from	to
<p>Mickey GORDON RR. Brookman ms. (mailing address)</p>	<p>Red Clay white chalk Conecog Sandstone</p>	<p>9 15 109</p>	<p>16 109 124</p>
<p>WELL LOCATION: sec. <u>3</u> T. <u>7</u> N. R. <u>8</u> E. S. W. <u>1</u> miles <u>south</u> of <u>Brookman</u> (distance) (direction) (nearest town)</p>			
<p>WELL PURPOSE: <u>Home</u> (home, irrigation, municipal, industrial)</p>			
<p>WELL COMPLETION DATA:</p> <p>(1) diameter (inches) <u>4</u></p> <p>(2) total depth (feet) <u>124</u></p> <p>(3) static water level (feet) <u>32</u> below top of ground.</p> <p>(4) casing <u>PVC</u>, <u>114</u>, (material) (depth) <u>4</u> if telescope see back. (size)</p> <p>(5) screen <u>10</u>, <u>114</u> (length) (depth to top) <u>4</u>, <u>PVC</u> (size) (material)</p> <p>(6) pump <u>1/2</u>, <u>10</u> (HP) (yield gpm) <u>Electric</u> (type power)</p> <p>(7) electric log <u>no</u> (yes or no) (organization running log)</p> <p>(8) how well bottom plugged <u>Sealed</u></p>			
<p>DRILLERS REMARKS:</p>			


RECEIVED

JUN 17 1994

Dept. of Environmental Quality  
Office of Land & Water Resources

If well telescopes please sketch and show depths.

GROUND LEVEL

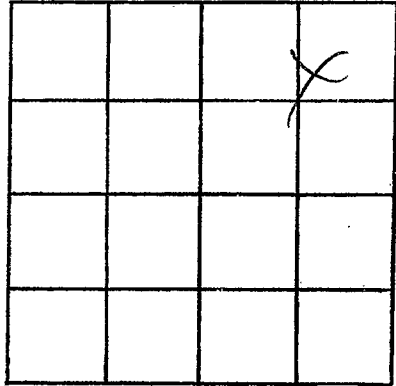

SECTION 30

Please indicate well location X.

ADDITIONAL INFORMATION

Lined area for additional information.

If more than one screen, show locations of each on sketch.