

**MISSISSIPPI DEPARTMENT OF ENVIRONMENTAL QUALITY**

Office of Land and Water Resources

P. O. Box 10631  
Jackson, MS 39289-0631

**WATER WELL DRILLERS LOG**

COUNTY WELL LOCATED <b>LINCOLN</b>	
WELL NUMBER <b>H 2094</b>	CODED
DATE WELL COMPLETED <b>May 26, 94</b>	

PERMIT NUMBER
NAME OF DRILLING FIRM <b>FITZGERALD Well Serv</b>

NAME & MAILING ADDRESS OF LANDOWNER <b>CHARLES ALLEN</b> <b>R.R. Brookhaven ms.</b>			
WELL LOCATION. SEC	TOWNSHIP	RANGE	
<b>27</b>	<b>7</b>	<b>N</b>	<b>8</b>
		<b>S</b>	<b>W</b>
DISTANCE	DIRECTION	NEAREST TOWN	
<b>1</b> Miles	<b>SE</b>	<b>Brookhaven</b>	
OTHER LANDMARK			
WELL PURPOSE: Home, Irrigation, Municipal, Industrial, Fish Pond, etc. <b>Home</b>			

<b>PUMP DATA</b>		
PUMP TYPE (Circle One): <b>Submersible</b> , Turbine, Jet, Flowing Well, Other (Describe)		
POWER TYPE (Circle One): Electric, Tractor, Diesel, Gasoline, Butane, Other (Describe) <b>1/2</b> H/P		
Pump Capacity (GPM) <b>10</b>	No. of Stages <b>8</b>	Setting Depth <b>80</b> FT.
PUMP TEST		
Well yielded <b>15</b> GPM with a drawdown of <b>2</b> ft. after <b>2</b> hours of pumping		

<b>WELL DATA</b>		
Well Depth <b>94</b>	Casing Diameter (In.) <b>4</b>	Casing Length (Ft.) <b>84</b>
Type of Casing <b>N/C</b>	Hole Depth <b>94</b>	Depth to Static Water Level <b>63</b>

<b>LOG DATA</b>	
TYPE OF LOG RUN (Circle One): Electric, Gamma Ray, Density, Sonic, Neutron, Other (Describe) <b>No Log Run</b>	
Name of Organization Running Log	

TYPE OF COMPLETION: (Circle One or More):  
 Gravel Packed,  Underreamed,  Telescoped,  
 Natural Development,  Open Hole,  Other  
 (Describe)

WELL GROUTED TO A DEPTH OF **10 FEET**  
 Type Grout (circle one): Cement, Bentonite, **or Mix**

<b>GEOLOGIC DATA (Office Use Only)</b>			
Surface Elev.	Geologic Unit	Unit Thickness	Depth to Top
Subs. SWL	Date	Analysis	Aquifer Test
Driller's Name			

<b>SCREEN DATA</b>		
Diameter - Inches <b>4</b>	Length - Feet <b>10</b>	Slot Size - Inches <b>10/12</b>
Screen Type <b>N/C</b>	Depth to Bottom - Feet <b>94</b>	

**RECEIVED**

**JUL 27 1994**

Top of Lap Pipe or Reduction in Casing

Dept. of Environmental Quality  
Office of Land & Water Resources


DESCRIPTION OF FORMATIONS ENCOUNTERED	FROM	TO
<b>Red Clay</b>	<b>0</b>	<b>20</b>
<b>Red Sand</b>	<b>20</b>	<b>77</b>
<b>Coarse sand &amp; gravel</b>	<b>77</b>	<b>94</b>

FORMATIONS (Continued)	FROM	TO

IF MORE SPACE IS NEEDED, USE BACK

If well telescopes please sketch and show depths.

GROUND LEVEL

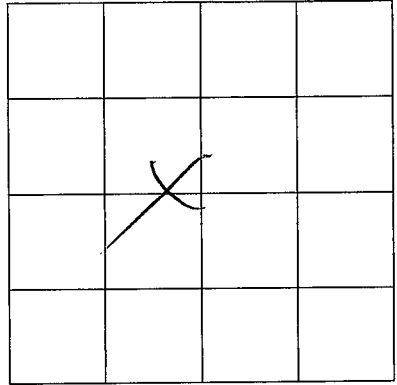

SECTION 27

Please indicate well location X.

ADDITIONAL INFORMATION

If more than one screen,  
show location of each on sketch.