

MISSISSIPPI DEPARTMENT OF ENVIRONMENTAL QUALITY

Office of Land and Water Resources

P. O. Box 10631  
Jackson, MS 39289-0631  
WATER WELL DRILLERS LOG

COUNTY WELL LOCATED  
LINCOLN

WELL NUMBER H 2095 CODED

PERMIT NUMBER

NAME OF DRILLING FIRM  
R. T. GERMAN Well Serv

DATE WELL COMPLETED  
June 4 94

NAME & MAILING ADDRESS OF LANDOWNER  
J. m CHAMBERS  
RR Brookhaven ms.

WELL LOCATION: SEC 27 TOWNSHIP 7 N S 8 E W RANGE

DISTANCE 1 Miles DIRECTION SE of NEAREST TOWN Brookhaven

OTHER LANDMARK

WELL PURPOSE: Home, Irrigation, Municipal, Industrial, Fish Pond, etc.  
Home

PUMP DATA

PUMP TYPE (Circle One):  
Submersible, Turbine, Jet, Flowing Well, Other (Describe)

POWER TYPE (Circle One):  
Electric, Tractor, Diesel, Gasoline, Butane, Other (Describe) 1/2

H/P

Pump Capacity (GPM) 10 No. of Stages 8 Setting Depth 95 FT.

PUMP TEST

Well yielded 15 GPM with a drawdown of 2 ft. after 2 hours of pumping

WELL DATA

Well Depth 135 Casing Diameter (In.) 4 Casing Length (Ft.) 125

Type of Casing pvc Hole Depth 135 Depth to Static Water Level 46

TYPE OF COMPLETION: (Circle One or More):  
Gravel Packed, Underreamed, Telescoped, Natural Development, Open Hole, Other (Describe)

WELL GROUTED TO A DEPTH OF 10 FEET  
Type Grout (circle one): Cement, Bentonite, or Mix

LOG DATA

TYPE OF LOG RUN (Circle One):  
Electric, Gamma Ray, Density, Sonic, Neutron, Other (Describe) No Log Run

Name of Organization Running Log

Geologic Data (Office Use Only)

Surface Elev.	Geologic Unit	Unit Thickness	Depth to Top

Subs. SW 1/4 Date July 27 1994 Aquifer Test

SCREEN DATA

Diameter - Inches 4 Length - Feet 10 Slot Size - Inches 1012

Screen Type pvc Depth to Bottom - Feet 135

Driller's Remarks

Dept. of Environmental Quality  
Office of Land & Water Resources

Top of Log Pipe or Reduction in Casing


FEET IF TELESKOPED OR MORE THAN ONE SCREEN: USE BACK PAGE

DESCRIPTION OF FORMATIONS ENCOUNTERED	FROM	TO	FORMATIONS (Continued)	FROM	TO
<u>Red Clay</u>	<u>0</u>	<u>15</u>			
<u>Red Sand</u>	<u>15</u>	<u>40</u>			
<u>White &amp; Blue clay</u>	<u>40</u>	<u>121</u>			
<u>Coarse Sand</u>	<u>121</u>	<u>135</u>			

IF MORE SPACE IS NEEDED, USE BACK

If well telescopes please  
sketch and show depths.

GROUND LEVEL

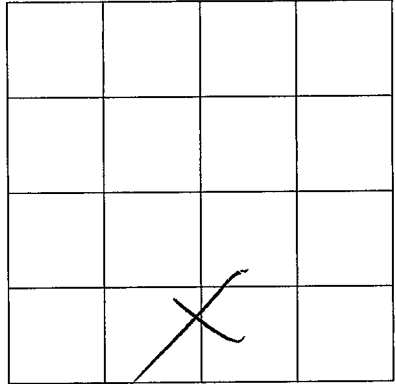

SECTION 27

Please indicate well location X.

ADDITIONAL INFORMATION

If more than one screen,  
show location of each on sketch.