

MISSISSIPPI DEPARTMENT OF ENVIRONMENTAL QUALITY

Office of Land and Water Resources

P. O. Box 10631
Jackson, MS 39289-0631
WATER WELL DRILLERS LOG

COUNTY WELL LOCATED Lincoln	
WELL NUMBER H	CODED 2097
DATE WELL COMPLETED 1-17-95	

PERMIT NUMBER
NAME OF DRILLING FIRM F. R. GERNARD Well Serv

NAME & MAILING ADDRESS OF LANDOWNER Redd Lumber Co.	
P.O. Box Brookhaven, ms.	

WELL LOCATION: SEC <u>5</u> TOWNSHIP <u>7</u> N RANGE <u>8</u> E W
--

DISTANCE <u>1</u> Miles DIRECTION <u>N</u> NEAREST TOWN <u>of Brookhaven</u>
--

OTHER LANDMARK
WELL PURPOSE: Home, Irrigation, Municipal, Industrial, Fish Pond, etc. WORK SHOP

PUMP DATA

PUMP TYPE (Circle One):
 Submersible, Turbine, Jet Flowing Well,
 Other (Describe) _____

POWER TYPE (Circle One):
 Electric, Tractor, Diesel, Gasoline, Butane,
 Other (Describe) _____ H/P 1

Pump Capacity (GPM) 20	No. of Stages 10	Setting Depth 95	FT.
----------------------------------	----------------------------	----------------------------	-----

PUMP TEST

Well yielded 55 GPM with
 a drawdown of 2 ft.
 after 2 hours of pumping

WELL DATA

Well Depth 155	Casing Diameter (In.) 4	Casing Length (Ft.) 145
Type of Casing PUL	Hole Depth 155	Depth to Static Water Level 61

TYPE OF COMPLETION: (Circle One or More):
 Gravel Packed, Underreamed, Telescoped,
 Natural Development, Open Hole, Other
 (Describe) _____

WELL GROUTED TO A DEPTH OF 10 FEET
 Type Grout (circle one): Cement, Bentonite, or Mix

SCREEN DATA

Diameter - Inches 4	Length - Feet 10	Slot Size - Inches .012
Screen Type PUL	Depth to Bottom - Feet 155	

LOG DATA

TYPE OF LOG RUN (Circle One):
 No Log Run,
 Electric, Gamma Ray, Density, Sonic, Neutron,
 Other (Describe) _____

Name of Organization Running Log

GEOLOGIC DATA (Office Use Only)

Surface Elev.	Geologic Unit	Unit Thickness	Depth to Top
Subs. SWL	Date	Analysis	Aquifer Test

Driller's Remarks

Top of Lap Pipe or Reduction in Casing


FEET IF TELESKOPED OR MORE THAN ONE SCREEN: USE BACK PAGE

DESCRIPTION OF FORMATIONS ENCOUNTERED	FROM	TO
Red Clay	0	10
Red Sand & gravel	10	75
White Chalk	75	140
Coarse Sand & gravel	140	155

FORMATIONS (Continued)	FROM	TO
RECEIVED		
FEB 13 1995		
Dept. of Environmental Quality Office of Land & Water Resources		
IF MORE SPACE IS NEEDED, USE BACK		

If well telescopes please
sketch and show depths.

GROUND LEVEL

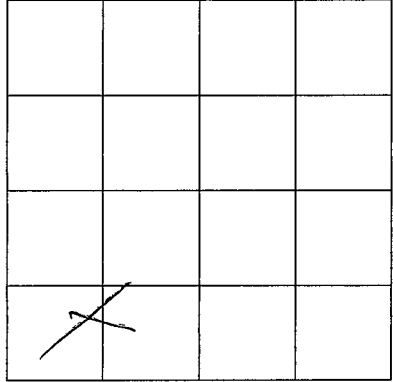

SECTION 5

Please indicate well location X.

ADDITIONAL INFORMATION

Lined area for additional information.

If more than one screen,
show location of each on sketch.