

**MISSISSIPPI DEPARTMENT OF ENVIRONMENTAL QUALITY**

Office of Land and Water Resources

P. O. Box 10631  
Jackson, MS 39289-0631  
**WATER WELL DRILLERS LOG**

COUNTY WELL LOCATED <i>Lincoln</i>	
WELL NUMBER <i>H 2110</i>	CODED
DATE WELL COMPLETED <i>7-10-98</i>	

PERMITTEE <b>Green Water Well &amp; Supply</b> 1318 Pricedale Dr. SE Bogue Chitto, MS 39629 . NAME OF DRILLING FIRM
---

NAME & MAILING ADDRESS OF LANDOWNER <i>James Swager</i>			
<i>1811 N. Jackson St.</i>			
<i>Brookhaven</i>			
WELL LOCATION:	SEC	TOWNSHIP	RANGE
	<i>6</i>	<i>7</i>	<i>8</i>
DISTANCE	DIRECTION	NEAREST TOWN	
<i>4</i> Miles	<i>N</i>	of <i>Brookhaven</i>	
OTHER LANDMARK			
WELL PURPOSE <input checked="" type="checkbox"/> Home Irrigation, Municipal, Industrial, Fish Pond, etc.			

PUMP DATA		
PUMP TYPE (Circle One): Submersible, Turbine, Jet, Flowing Well, Other (Describe) _____		
POWER TYPE (Circle One): <input checked="" type="checkbox"/> Electric, Tractor, Diesel, Gasoline, Butane, Other (Describe) _____ <i>H/P 3/4</i>		
Pump Capacity (GPM)	No. of Stages	Setting Depth
<i>10</i>	<i>12</i>	<i>80'</i> FT.
PUMP TEST		
Well yielded <i>10</i> GPM with a drawdown of <i>0</i> ft. after <i>1</i> hours of pumping		

WELL DATA		
Well Depth <i>130'</i>	Casing Diameter (In.) <i>4"</i>	Casing Length (Ft.) <i>120'</i>
Type of Casing <i>PVC</i>	Hole Depth <i>144</i>	Depth to Static Water Level <i>52'</i>

LOG DATA	
TYPE OF LOG RUN (Circle One): <input checked="" type="checkbox"/> No Log Run Electric, Gamma Ray, Density, Sonic, Neutron, Other (Describe) _____	
Name of Organization Running Log	

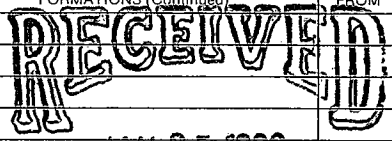
TYPE OF COMPLETION: (Circle One or More):  
 Gravel Packed, Underreamed, Telescoped,  
 Natural Development, Open Hole, Other  
 (Describe) \_\_\_\_\_

WELL GROUTED TO A DEPTH OF *10* FEET  
 Type Grout (circle one): Cement, Bentonite,  Mix

GEOLOGIC DATA (Office Use Only)			
Surface Elev.	Geologic Unit	Unit Thickness	Depth to Top
Subs. SWL	Date	Analysis	Aquifer Test
Driller's Remarks			
Top of Lap Pipe or Reduction in Casing			
FEET	IF TELESCOPED OR MORE THAN ONE SCREEN: USE BACK PAGE		

SCREEN DATA		
Diameter - Inches <i>4"</i>	Length - Feet <i>10'</i>	Slot Size - Inches <i>.010</i>
Screen Type <i>PVC</i>	Depth to Bottom - Feet <i>130'</i>	

DESCRIPTION OF FORMATIONS ENCOUNTERED	FROM	TO
<i>Red Sandy Clay</i>	<i>0</i>	<i>48</i>
<i>Sand &amp; Gravel</i>	<i>48</i>	<i>80</i>
<i>White Clay</i>	<i>80</i>	<i>92</i>
<i>Sand</i>	<i>92</i>	<i>134</i>
<i>White clay</i>	<i>134</i>	<i>144</i>

FORMATIONS (Continued)	
FROM	TO
	
JAN 25 1999	
Dept. of Environmental Quality Office of Land & Water Resources	
IF MORE SPACE IS NEEDED, USE BACK	

If well telescopes please sketch and show depths.

GROUND LEVEL

	X		

SECTION 6

Please indicate well location X.

ADDITIONAL INFORMATION

RESERVED

NOV 2 1980

Produced under the  
aegis of the U.S. Geological Survey

If more than one screen,  
show location of each on sketch.