

**MISSISSIPPI DEPARTMENT OF ENVIRONMENTAL QUALITY**

Office of Land and Water Resources

P. O. Box 10631  
Jackson, MS 39289-0631  
**WATER WELL DRILLERS LOG**

COUNTY WELL LOCATED <i>Lumbard</i>	
WELL NUMBER <i>H 2113</i>	CODED
DATE WELL COMPLETED <i>6-27-98</i>	

Crown Water Well & Supply 1318 Pricedale Dr. SE Bogue Chitto, MS 39629
--

NAME & MAILING ADDRESS OF LANDOWNER <i>Curtis Young</i> <i>611 Mockingbird Dr.</i> <i>Brookhaven</i>			
WELL LOCATION:	SEC <i>6</i>	TOWNSHIP <i>7 N S</i>	RANGE <i>8 E W</i>
DISTANCE <i>1/4</i> Miles	DIRECTION <i>N</i>	NEAREST TOWN <i>Brookhaven</i>	
OTHER LANDMARK			
WELL PURPOSE: <input checked="" type="checkbox"/> Home Irrigation, Municipal, Industrial, Fish Pond, etc.			

PUMP DATA		
PUMP TYPE (Circle One): <input checked="" type="checkbox"/> Submersible, <input type="checkbox"/> Turbine, <input type="checkbox"/> Jet <input type="checkbox"/> Flowing Well, Other (Describe) _____		
POWER TYPE (Circle One): <input checked="" type="checkbox"/> Electric, <input type="checkbox"/> Tractor, <input type="checkbox"/> Diesel, <input type="checkbox"/> Gasoline, <input type="checkbox"/> Butane, Other (Describe) _____ H/P <i>1</i>		
Pump Capacity (GPM) <i>16</i>	No. of Stages <i>10</i>	Setting Depth <i>85</i> FT.
PUMP TEST		
Well yielded <i>16</i> GPM with a drawdown of <i>0</i> ft. after <i>1</i> hours of pumping		

WELL DATA		
Well Depth <i>150'</i>	Casing Diameter (In.) <i>4"</i>	Casing Length (Ft.) <i>140'</i>
Type of Casing <i>PVC</i>	Hole Depth <i>160'</i>	Depth to Static Water Level <i>53'</i>

TYPE OF COMPLETION: (Circle One or More):  
 Gravel Packed,  Underreamed,  Telescoped,  
 Natural Development,  Open Hole,  Other  
 (Describe) \_\_\_\_\_

WELL GROUTED TO A DEPTH OF *10* FEET  
 Type Grout (circle one): Cement, Bentonite, or  Mix

SCREEN DATA		
Diameter - Inches <i>4"</i>	Length - Feet <i>10'</i>	Slot Size - Inches <i>.010</i>
Screen Type <i>PVC</i>	Depth to Bottom - Feet <i>150'</i>	

LOG DATA	
TYPE OF LOG RUN (Circle One): <input checked="" type="checkbox"/> No Log Run, Electric, Gamma Ray, Density, Sonic, Neutron, Other (Describe) _____	
Name of Organization Running Log	

GEOLOGIC DATA (Office Use Only)			
Surface Elev.	Geologic Unit	Unit Thickness	Depth to Top
Subs. SWL	Date	Analysis	Aquifer Test

Driller's Remarks

---

Top of Lap Pipe or Reduction in Casing

FEET	IF TELESCOPED OR MORE THAN ONE SCREEN: USE BACK PAGE
------	--

DESCRIPTION OF FORMATIONS ENCOUNTERED	FROM	TO
<i>Red Clay</i>	<i>0</i>	<i>35</i>
<i>Gravel/Sand</i>	<i>35</i>	<i>153</i>
<i>Yellow Clay</i>	<i>153</i>	<i>160</i>

FORMATIONS (Continued)	FROM	TO
<b>RECEIVED</b>		
<b>JAN 25 1999</b>		
Dept. of Environmental Quality Office of Land & Water Resources		

IF MORE SPACE IS NEEDED, USE BACK

If well telescopes please sketch and show depths.


GROUND LEVEL

	X		

SECTION 6

Please indicate well location X.

ADDITIONAL INFORMATION

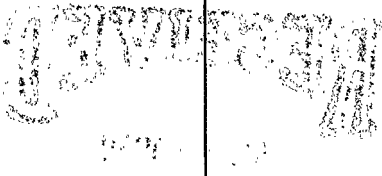

*[Faint, illegible text]*

If more than one screen,  
show location of each on sketch.