

MISSISSIPPI DEPARTMENT OF ENVIRONMENTAL QUALITY

Office of Land and Water Resources

P. O. Box 10631
Jackson, MS 39289-0631
WATER WELL DRILLERS LOG

| | |
|---------------------------------------|-------|
| COUNTY WELL LOCATED <i>Lincoln</i> | |
| WELL NUMBER <i>H 215</i> | CODED |
| DATE WELL COMPLETED <i>8-27-98</i> | |

| |
|--|
| PERFORMED BY <i>Green Water Well & Supply</i> |
| 1318 Pricedale Dr. SE |
| NAME OF DRILLING FIRM <i>Bogue Chitto, MS 39629</i> |

| | | |
|--|------------|----------------------|
| NAME & MAILING ADDRESS OF LANDOWNER <i>Eric Boyd</i> | | |
| <i>1591 Monticello # NB</i> | | |
| <i>Brookhaven</i> | | |
| WELL LOCATION: SEC | TOWNSHIP | RANGE |
| <i>22</i> | <i>7 S</i> | <i>8 W</i> |
| DISTANCE | DIRECTION | NEAREST TOWN |
| <i>2</i> Miles | <i>E</i> | of <i>Brookhaven</i> |
| OTHER LANDMARK | | |
| WELL PURPOSE: <input checked="" type="checkbox"/> Home Irrigation, <input type="checkbox"/> Municipal, <input type="checkbox"/> Industrial, <input type="checkbox"/> Fish Pond, etc. | | |

| | | |
|---|---------------------------|---------------------------------|
| PUMP DATA | | |
| PUMP TYPE (Circle One): <input checked="" type="checkbox"/> Submersible, <input type="checkbox"/> Turbine, <input type="checkbox"/> Jet, <input type="checkbox"/> Flowing Well, Other (Describe) _____ | | |
| POWER TYPE (Circle One): <input checked="" type="checkbox"/> Electric, <input type="checkbox"/> Tractor, <input type="checkbox"/> Diesel, <input type="checkbox"/> Gasoline, <input type="checkbox"/> Butane, Other (Describe) _____ H/P <i>1 1/2</i> | | |
| Pump Capacity (GPM) <i>25</i> | No. of Stages <i>9</i> | Setting Depth <i>100</i> FT. |
| PUMP TEST | | |
| Well yielded <i>25</i> GPM with a drawdown of <i>10</i> ft. after <i>1</i> hours of pumping | | |

| | | |
|--|------------------------------------|--|
| WELL DATA | | |
| Well Depth <i>108'</i> | Casing Diameter (In.) <i>4"</i> | Casing Length (Ft.) <i>38'</i> |
| Type of Casing <i>PVC</i> | Hole Depth <i>118'</i> | Depth to Static Water Level <i>68</i> |
| TYPE OF COMPLETION: (Circle One or More): <input checked="" type="checkbox"/> Gravel Packed, <input type="checkbox"/> Underreamed, <input type="checkbox"/> Telescoped, <input type="checkbox"/> Natural Development, <input type="checkbox"/> Open Hole, <input type="checkbox"/> Other (Describe) _____ | | |

| | |
|---|--|
| LOG DATA | |
| TYPE OF LOG RUN (Circle One): <input checked="" type="checkbox"/> No Log Run, <input type="checkbox"/> Electric, <input type="checkbox"/> Gamma Ray, <input type="checkbox"/> Density, <input type="checkbox"/> Sonic, <input type="checkbox"/> Neutron, Other (Describe) _____ | |
| Name of Organization Running Log | |


| |
|---|
| WELL GROUTED TO A DEPTH OF <i>10</i> FEET Type Grout (circle one): Cement, Bentonite, or <input checked="" type="checkbox"/> Mix |
|---|

| | | | |
|--|---------------|--|--------------|
| GEOLOGIC DATA (Office Use Only) | | | |
| Surface Elev. | Geologic Unit | Unit Thickness | Depth to Top |
| Subs. SWL | Date | Analysis | Aquifer Test |
| Driller's Remarks | | | |
| Top of Lap Pipe or Reduction in Casing | | | |
| FEET | | IF TELESCOPED OR MORE THAN ONE SCREEN: USE BACK PAGE | |

| | | |
|--------------------------------|---------------------------------------|-----------------------------------|
| SCREEN DATA | | |
| Diameter - Inches <i>4"</i> | Length - Feet <i>20'</i> | Slot Size - Inches <i>.010</i> |
| Screen Type <i>PVC</i> | Depth to Bottom - Feet <i>168'</i> | |

| DESCRIPTION OF FORMATIONS ENCOUNTERED | FROM | TO |
|---------------------------------------|------------|------------|
| <i>White Clay</i> | <i>0</i> | <i>15</i> |
| <i>Red Clay</i> | <i>15</i> | <i>35</i> |
| <i>Sand & Gravel</i> | <i>35</i> | <i>108</i> |
| <i>White Clay</i> | <i>108</i> | <i>118</i> |
| | | |
| | | |
FOR CATIONS TO BE DETERMINED FROM

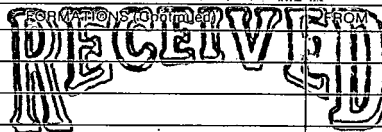


JAN 25 1999

Dept. of Environmental Quality
Office of Land & Water Resources

IF MORE SPACE IS NEEDED, USE BACK

If well telescopes please sketch and show depths.


GROUND LEVEL

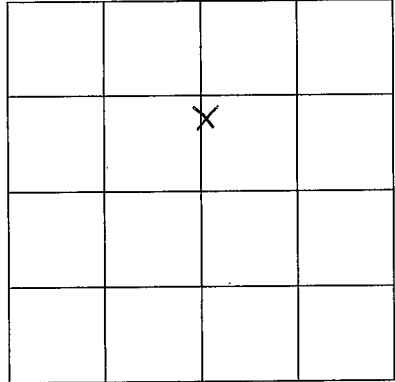

SECTION 22

Please indicate well location X.

ADDITIONAL INFORMATION

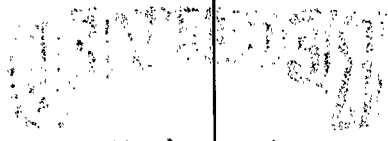

If more than one screen,
show location of each on sketch.