

**MISSISSIPPI DEPARTMENT OF ENVIRONMENTAL QUALITY**

Office of Land and Water Resources

P. O. Box 10631  
Jackson, MS 39289-0631  
**WATER WELL DRILLERS LOG**

COUNTY, WELL LOCATED <i>Lincoln</i>	
WELL NUMBER <i>112117</i>	CODED
DATE WELL COMPLETED <i>2-4-99</i>	

PUMP NUMBER <b>Green Water Well &amp; Supply</b> 1318 Pricedale Dr. SE Bogue Chitto, MS 39629
NAME OF DRILLING FIRM

NAME & MAILING ADDRESS OF LANDOWNER <i>Lincoln Lumber</i>		
<i>P.O. Box 453</i>		
<i>Brookhaven</i>		
WELL LOCATION:	SEC <u>21</u>	TOWNSHIP <u>7</u> <sup>N</sup> <u>8</u> <sup>E</sup> <sub>W</sub>
DISTANCE	DIRECTION	NEAREST TOWN
<u>1</u> Miles	<u>E</u>	of <u>Brookhaven</u>
OTHER LANDMARK		
WELL PURPOSE: Home, Irrigation, Municipal, <u>Industrial</u> , Fish Pond, etc.		

PUMP DATA		
PUMP TYPE (Circle One): <u>Submersible</u> , Turbine, Jet, Flowing Well, Other (Describe) _____		
POWER TYPE (Circle One): <u>Electric</u> , Tractor, Diesel, Gasoline, Butane, Other (Describe) _____ H/P <u>2</u>		
Pump Capacity (GPM) <u>25</u>	No. of Stages <u>11</u>	Setting Depth <u>100'</u> FT.
PUMP TEST		
Well yielded <u>25</u> GPM with a drawdown of <u>10</u> ft. after <u>1</u> hours of pumping		

WELL DATA		
Well Depth <u>110'</u>	Casing Diameter (In.) <u>4"</u>	Casing Length (Ft.) <u>90'</u>
Type of Casing <u>PVC</u>	Hole Depth	Depth to Static Water Level <u>49'</u>

LOG DATA	
TYPE OF LOG RUN (Circle One): Electric, Gamma Ray, Density, Sonic, <u>No Log Run</u> , Other (Describe) _____	
Name of Organization Running Log	

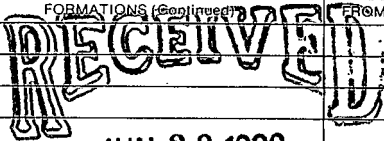
TYPE OF COMPLETION: (Circle One or More):  
 Gravel Packed,     Underreamed,     Telescoped,  
 Natural Development,     Open Hole,     Other  
 (Describe) \_\_\_\_\_

WELL GROUTED TO A DEPTH OF 10 FEET  
 Type Grout (circle one): Cement, Bentonite, or Mix

GEOLOGIC DATA (Office Use Only)			
Surface Elev.	Geologic Unit	Unit Thickness	Depth to Top
Subs. SWL	Date	Analysis	Aquifer Test
Driller's Remarks			
Top of Lap Pipe or Reduction in Casing			
FEET		IF TELESCOPED OR MORE THAN ONE SCREEN: USE BACK PAGE	

SCREEN DATA		
Diameter - Inches <u>4"</u>	Length - Feet <u>20'</u>	Slot Size - Inches <u>.010</u>
Screen Type <u>PVC</u>	Depth to Bottom - Feet <u>110'</u>	

DESCRIPTION OF FORMATIONS ENCOUNTERED	FROM	TO
<i>Red Clay</i>	<u>0</u>	<u>50</u>
<i>Sand Gravel</i>	<u>50</u>	<u>110</u>
<i>White Clay</i>	<u>110</u>	<u>117</u>

FORMATIONS (Continued)	
FROM	TO
 JUN 28 1999	
Dept. of Environmental Quality Office of Land & Water Resources	
IF MORE SPACE IS NEEDED, USE BACK	

If well telescopes please sketch and show depths.

GROUND LEVEL

	X		

SECTION \_\_\_\_\_

Please indicate well location X.

ADDITIONAL INFORMATION

If more than one screen,  
show location of each on sketch.