

# MISSISSIPPI DEPARTMENT OF ENVIRONMENTAL QUALITY

Office of Land and Water Resources

P. O. Box 10631  
Jackson, MS 39289-0631  
**WATER WELL DRILLERS LOG**

COUNTY WELL LOCATED <u>Lincoln</u>	
WELL NUMBER <u>H-2126</u>	CODED
DATE WELL COMPLETED <u>6-6-00</u>	

PERMIT NUMBER <u>0-621</u>
NAME OF DRILLING FIRM <u>Daniel Boone</u>

NAME & MAILING ADDRESS OF LANDOWNER <u>John Dan's</u>			
<u>1622 Maura Ln.</u>			
<u>Brookhaven, MS</u>			
WELL LOCATION:	SEC.	TOWNSHIP	RANGE.
	<u>28</u>	<u>7</u>	<u>8</u>
		<u>N</u>	<u>W</u>
		<u>S</u>	
DISTANCE	DIRECTION	NEAREST TOWN	
<u>3</u>	<u>SE</u>	<u>Brookhaven</u>	
OTHER LANDMARK			
WELL PURPOSE (Home, Irrigation, Municipal, Industrial, Fish Pond, etc.) <u>(Home)</u>			


PUMP DATA			
PUMP TYPE (Circle One): <input checked="" type="radio"/> Submersible, <input type="radio"/> Turbine, <input type="radio"/> Jet, <input type="radio"/> Flowing Well, Other (Describe) _____			
POWER TYPE (Circle One): <input checked="" type="radio"/> Electric, <input type="radio"/> Tractor, <input type="radio"/> Diesel, <input type="radio"/> Gasoline, <input type="radio"/> Butane, Other (Describe) _____			
Pump Capacity (GPM) <u>12</u>	No. of Stages	Setting Depth <u>65</u>	FT.
PUMP-TEST: Well-yielded <u>18</u> GPM with a drawdown of <u>20</u> ft. after <u>8</u> hours of pumping			

WELL DATA		
Well Depth <u>85</u>	Casing Diameter (In.) <u>4"</u>	Casing Length (Feet) <u>65'</u>
Type of Casing <u>PVC</u>	Hole Depth <u>85'</u>	Depth to Static Water Level <u>38'</u>
TYPE OF COMPLETION: (Circle One or More): <input checked="" type="checkbox"/> Gravel Packed, <input type="checkbox"/> Underreamed, <input type="checkbox"/> Telescoped, <input type="checkbox"/> Natural Development, <input type="checkbox"/> Open Hole, <input type="checkbox"/> Other (Describe) _____		
WELL GROUTED TO A DEPTH OF <u>9</u> FEET Type Grout (circle one): <input checked="" type="radio"/> Cement, <input type="radio"/> Bentonite, or Mix		

LOG DATA	
TYPE OF LOG RUN (Circle One): <input checked="" type="radio"/> Electric, <input type="radio"/> Gamma Ray, <input type="radio"/> Density, <input type="radio"/> Sonic, <input type="radio"/> Neutron, Other (Describe) _____	
Name of Organization Running Log _____	

SCREEN DATA		
Diameter - Inches <u>4"</u>	Length - Feet <u>20'</u>	Slot Size - Inches: <u>.008</u>
Screen Type <u>PVC Sch. 40</u>	Depth to Bottom - Feet <u>0</u>	

GEOLOGIC DATA (Office Use Only)			
Surface Elev.	Geologic Unit	Unit Thickness	Depth to Top
Subs. SWL	Date	Analysis	Aquifer Test

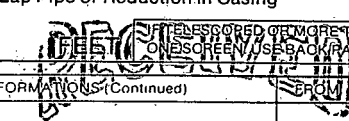Driller's Remarks	
Top of Lap Pipe or Reduction in Casing	
	

DESCRIPTION OF FORMATIONS ENCOUNTERED	FROM	TO	FORMATIONS (Continued)	FROM	TO


AUG 07 2000

Dept. of Environmental Quality  
Office of Land & Water Resources

IF MORE SPACE IS NEEDED, USE BACK

If well telescopes please sketch and show depths.

GROUND LEVEL

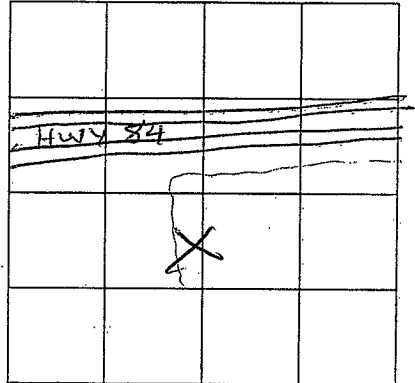

SECTION 28

Please indicate well location X.

ADDITIONAL INFORMATION

WATERBURY

NOV 1 1968

DEPT. OF HEALTH & HUMAN SERVICES  
FEDERAL BUREAU OF INVESTIGATION

If more than one screen,  
show location of each on sketch.