

**MISSISSIPPI DEPARTMENT OF ENVIRONMENTAL QUALITY**  
Office of Land and Water Resources

COUNTY WELL LOCATED  
L.ircola

WELL NUMBER \_\_\_\_\_ CODED \_\_\_\_\_

H 2130

DATE WELL COMPLETED  
6/8/01

PERMIT NUMBER  
**Green Water Well & Supply**

NAME OF WELLER  
1014 Prichard Dr. SE  
Bogue Chitto, MS 39629

P. O. Box 10631  
Jackson, MS 39289-0631  
**WATER WELL DRILLERS LOG**

NAME & MAILING ADDRESS OF LANDOWNER  
Kenneth Goza

976 Crooked Ln

Brookhaven

WELL LOCATION: SEC B TOWNSHIP 7 RANGE S 8 W

DISTANCE 1/2 Miles DIRECTION East of NEAREST TOWN Brookhaven

OTHER LANDMARK \_\_\_\_\_

WELL PURPOSE:  Home,  Irrigation,  Municipal,  Industrial,  Fish Pond, etc.

**PUMP DATA**

PUMP TYPE (Circle One):  
 Submersible,  Turbine,  Jet,  Flowing Well,  
Other (Describe) \_\_\_\_\_

POWER TYPE (Circle One):  
 Electric,  Tractor,  Diesel,  Gasoline,  Butane,  
Other (Describe) \_\_\_\_\_ H/P \_\_\_\_\_

Pump Capacity (GPM) 10 No. of Stages 9 Setting Depth 70' FT.

PUMP TEST

Well yielded 11 GPM with  
a drawdown of 0 ft.  
after 1 hours of pumping

**WELL DATA**

Well Depth <u>140'</u>	Casing Diameter (In.) <u>4"</u>	Casing Length (Ft.) <u>130'</u>
Type of Casing <u>PVC</u>	Hole Depth <u>168</u>	Depth to Static Water Level <u>37'</u>

TYPE OF COMPLETION: (Circle One or More):  
 Gravel Packed,  Underreamed,  Telescoped,  
 Natural Development,  Open Hole,  Other  
(Describe) \_\_\_\_\_

**LOG DATA**

TYPE OF LOG RUN (Circle One):  No Log Run,  
 Electric,  Gamma Ray,  Density,  Sonic,  Neutron,  
Other (Describe) \_\_\_\_\_

Name of Organization Running Log \_\_\_\_\_

WELL GROUTED TO A DEPTH OF 10 FEET  
Type Grout (circle one): Cement, Bentonite, or  Mix

**GEOLOGIC DATA (Office Use Only)**

Surface Elev.	Geologic Unit	Unit Thickness	Depth to Top
Subs. SWL	Date	Analysis	Aquifer Test

**SCREEN DATA**

Diameter - Inches <u>4"</u>	Length - Feet <u>10'</u>	Slot Size - Inches <u>.010</u>
Screen Type <u>PVC</u>	Depth to Bottom - Feet <u>140'</u>	

Driller's Remarks \_\_\_\_\_

Top of Lap Pipe or Reduction in Casing \_\_\_\_\_

FEET IF TELESCOPED OR MORE THAN ONE SCREEN: USE BACK PAGE

DESCRIPTION OF FORMATIONS ENCOUNTERED	FROM	TO
<u>Red Clay</u>	<u>0</u>	<u>18</u>
<u>Streaky</u>	<u>18</u>	<u>35</u>
<u>Sand</u>	<u>35</u>	<u>56</u>
<u>White Clay</u>	<u>56</u>	<u>65</u>
<u>Sand &amp; Gravel</u>	<u>65</u>	<u>162</u>
<u>Yellow Clay</u>	<u>162</u>	<u>168</u>


FORMATIONS (Continued)	FROM	TO

**REC'D JUN 13 2001**

IF MORE SPACE IS NEEDED, USE BACK

If well telescopes please  
sketch and show depths.

GROUND LEVEL

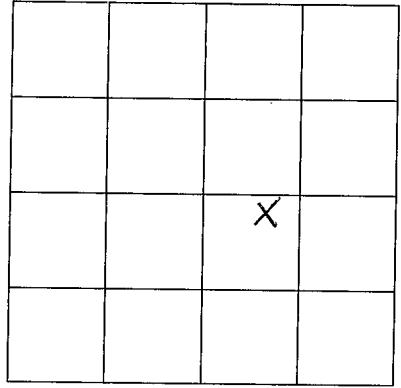

SECTION 8

Please indicate well location X.

ADDITIONAL INFORMATION

If more than one screen,  
show location of each on sketch.