

LINCOLN

J1

WATER WELL DRILLERS LOG

J-300

12-12-60 CODED

Date: 12-12, 1960, Driller: W J Fitzgerald County: Lincoln

(1) Owner of Land: Earl Ward
 (Name)
 Brookhaven Miss
 (Address)

(2) Location: SW 1/4, SE 1/4, Sec. 8, T. 19 N, R. 9 E
 5 miles NE of Brookhaven
 (distance) (direction) (Nearest Town)

(3) Topography: Level
 (Hilly) (Flat) (Level)

(4) Purpose of Well: Horse Use
 (Domestic Irrigation
 Municipal, Industrial, Other)

Description & Color of Materials Sand, Clay, Red Clay, Shell, etc.	Thick- ness Feet	Depth Feet
Topsoil	0	15
Red sand	15	40
sand + gravel	40	65
White Chalk	65	90
Fine Sand	90	120
Coarse Sand	120	135

Information upon completion of well:

(1) Diameter 4 inches.

(2) Total Depth 139 feet.

(3) Water Level 60 feet below top of ground.

(4) Cased to 127, Size 4"

(5) Screen: Size 2", Length 5' 5" steel


(6) Were any formations sealed against pollution?
 _____ yes, no.

If YES depth of formation _____

Why _____

Drillers Remarks: _____

CODED

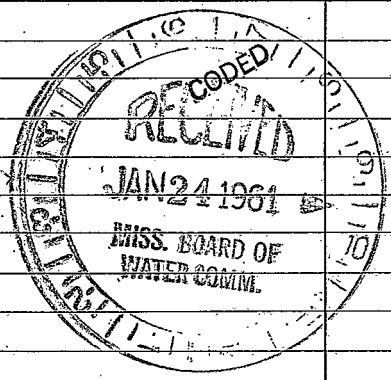

(Use Back Side)

Well No.

