

LINCOLN  
J3

MISSISSIPPI BOARD OF WATER COMMISSIONERS

6-15-65 CODED WATER WELL DRILLERS LOG

Date: 6-15, 1965, Driller: Chester Seems County Lincoln  
(Name)

(1) Owner of Land: James Benge  
(Name)  
RFD, Brookhaven  
(Address)

(2) Location: 1/4, 1/4, Sec. 5, T. 19, R. 19  
7 miles N.E. Brookhaven  
(distance) (direction) (Nearest Town)

(3) Topography: Hilly  
(Hilly) (Flat) (Level)

(4) Purpose of Well: Domestic  
(Domestic Irrigation, Municipal, Industrial, Other)

Description & Color of Materials Sand, Clay, Red Clay, Shell, etc.	Thick- ness Feet	Depth Feet
Clay	15	15
Red sand & clay	70	85
sand & clay		
gravel	9	94

Information upon completion of well:


- (1) Diameter 4 inches.
- (2) Total Depth 94 feet.
- (3) Water Level 77 feet below top of ground.
- (4) Cased to bottom size 4"
- (5) Screen: Size 4', Length 7'
- (6) Were any formations sealed against pollution?  
yes,  no.

If YES depth of formation \_\_\_\_\_

Why \_\_\_\_\_

Drillers Remarks: good well  
Bad

CODED

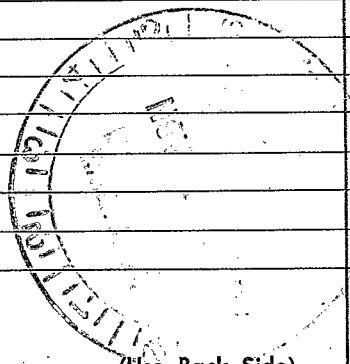

(Use Back Side)

Well No.

100

101

102

200