

LINCOLN

JA

MISSISSIPPI BOARD OF WATER COMMISSIONERS

6-22-66

CODED WATER WELL DRILLERS LOG

Date: June 22, 1966, Driller: Chester Reeves County: Lincoln
(When well drilled) (Name) (Where well is located)

(1) Owner of Land: Millard Farmer
(Name)
Rt-1, Brookhaven
(Address)

(2) Location: 1/4, 1/4, Sec. 18 T 2 R 9
7 miles N.E. Brookhaven
(distance) (direction) (Nearest Town)

(3) Topography: Hilly
(Hilly) (Flat) (Level)

(4) Purpose of Well: Domestic
(Domestic Irrigation
Municipal, Industrial, Other)

Description & Color of Materials Sand, Clay, Red Clay, Shale, etc.	Thick- ness Feet	Depth Feet
<u>Clay gravel</u>	<u>15</u>	<u>15</u>
<u>Sand & gravel</u>	<u>15</u>	<u>30</u>
<u>white chalk</u>	<u>40</u>	<u>110</u>
<u>white fine sand</u>	<u>15</u>	<u>125</u>
<u>Coarse sand</u>	<u>10</u>	<u>135</u>

Information upon completion of well:

(1) Diameter: 4 inches.


(2) Total Depth: 135 feet.

(3) Water Level: 77 feet below top of ground.

(4) Cased to bottom Size 4

(5) Screen: Size 4", Length 6'

(6) Were any formations sealed against pollution?
no

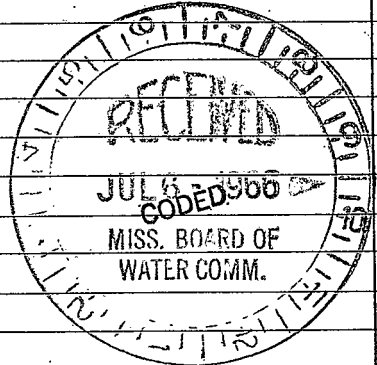

If YES depth of formation _____

Why _____

Drillers Remarks: No previous well

Yield in gpm: 4

Size pump: 1/2 H.P. Sub.

Type power: Electric

REEVES WELL & PUMP CO.
P. O. BOX 71 -- PHONE 684-1451
McCOMB, MISS.

...the ...

...the ...

