

Lincoln
 25
 4-67 CODED

MISSISSIPPI
 BOARD OF WATER COMMISSIONERS
 416 North State Street
 Jackson, Mississippi 39201

WATER WELL DRILLERS LOG

April 11 1967 G. REEVES WELLS & PUMPS Lincoln
 date well completed firm name county well located

LANDOWNER: W. D. Stuard

description of formations encountered from to

FARMS
 P.O. Brookhaven
 (mailing address)

Hard clay Sand	0	15
white & blue ball	15	47
Coarse sand		
fine sand	47	55
Coarse sand	55	79
Sand & gravel	79	106

WELL LOCATION:
 sec. 33 T7 N R9 E
 2 miles S Ferris Springs
 (distance) (direction) (nearest town)

WELL PURPOSE: Home
 (home, irrigation, municipal, industrial)

WELL COMPLETION DATA:

- (1) diameter (inches) 4"
- (2) total depth (feet) 106
- (3) static water level (feet) 50 below top of ground.
- (4) casing Plastic (material) Bottom (depth)
- 4 (size) if telescope see back.
- (5) screen 6' (length) 100 (depth to top)
- 4" (size) Plastic (material)
- (6) pump No Pump (HP) (yield gpm)
- (type power)
- (7) electric log No (yes or no)
- (organization running log)
- (8) how well bottom plugged wooden plug


DRILLERS REMARKS:

CODED



If well telescopes please sketch and show depths.

GROUND LEVEL

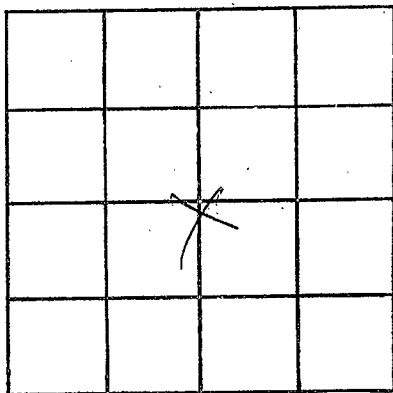

SECTION 3

Please indicate well location X.

ADDITIONAL INFORMATION

If more than one screen, show locations of each on sketch.