

MISSISSIPPI
BOARD OF WATER COMMISSIONERS
416 North State Street
Jackson, Mississippi 39201

WATER WELL DRILLERS LOG

Lincoln
J6
6-67
CODED

June 6 1967 Keenesville Rumpke Lincoln
date well completed firm name county well located

LANDOWNER: David Townsend
H-1, Brookhaven
(mailing address)


description of formations encountered	from	to
<u>Red chert</u>	<u>0</u>	<u>35</u>
<u>Hard blue shale</u>	<u>35</u>	<u>105</u>
<u>fine sand</u>	<u>105</u>	<u>188</u>

WELL LOCATION:
sec 22 T 1 N R 9 E
9 miles E Brookhaven
(distance) (direction) (nearest town)

WELL PURPOSE: Domestic
(home, irrigation, municipal, industrial)

- WELL COMPLETION DATA:
- (1) diameter (inches) 7"
 - (2) total depth (feet) 188
 - (3) static water level (feet) 91 below top of ground.
 - (4) casing steel bottom
(material) (depth)
 - 2" if telescope see back.
(size)
 - (5) screen 6' 182'
(length) (depth to top)
1/4 stainless steel
(size) (material)
 - (6) pump 1/2 5
(HP) (yield gpm)
elect
(type power)
 - (7) electric log No
(yes or no)
 - (organization running log)
 - (8) how well bottom plugged fall in


CODED

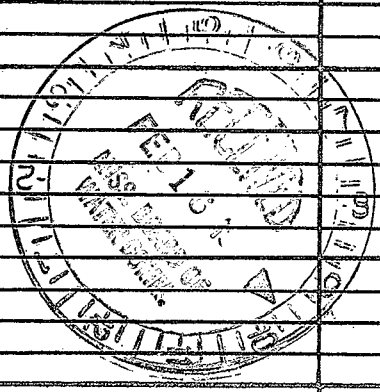

DRILLERS REMARKS:
New location

If well telescopes please sketch and show depths.

GROUND LEVEL

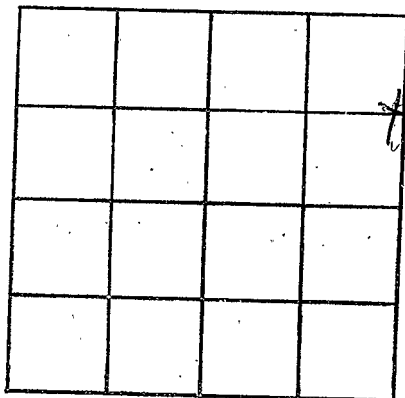

SECTION 22

Please indicate well location X.

ADDITIONAL INFORMATION

If more than one screen, show locations of each on sketch.