

LINCOLN
57

OK J.R.
10/17/68

WATER WELL DRILLERS LOG

9-27-68


Date: 9/27/1968, Driller: Ray Schudler, Jr. County: Lincoln
(Name)

(1) Owner of Land: Mr. Jack Williams
(Name)
Brookhaven, Miss
(Address)
(2) Location: East of Brookhaven
1/4 Sec. 18 T. 4 N. E. 9
_____ miles _____ of _____
(distance) (direction) (Nearest Town)
(3) Topography: (Hilly) (Flat) (Level)
(4) Purpose of Well: house
(Domestic, Irrigation, Municipal, Industrial, Other)

Description & Color of Materials Sand, Clay, Red Clay, Shell, etc.	Thick- ness Feet	Depth Feet
yellow clay	3	3
Dravel & Red Clay	37	37
gray slip clay water sand	3	3
Sealed off w/ carson		
gray clay	29	29
tight very weak water sand	1	1

Information upon completion of well:

(1) Diameter: 15" inches.
(2) Total Depth: 72 feet.
(3) Water Level: 43' feet below top of ground.
(4) Cased to: 72', Size: 15"
(5) Screen: Size None, Length _____
(6) Were any formations sealed against pollution?
Surface 4 feet down
yes, no.

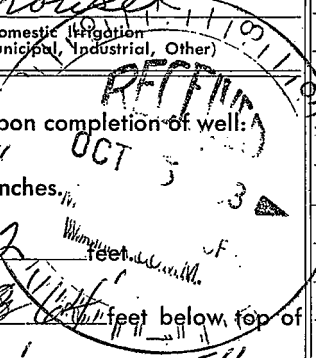

If YES depth of formation _____
Why: Keep out surface water
Drillers Remarks: Reached weak vein at 40' - ran into still weaker vein at 72'

Failed to make 1st reservoir well on account of hitting seep at 71' & water should have risen up to the 1st. vein around 43' - instead vein at 43' continues to pour into well and only stands 3' or ~~4'~~ ^{CODED} in well. Well seems to be gradually gaining head as lower vein may eventually become sealed off. Top vein pours into well continuously. Should furnish house by user being easy with his water.

