

Lincoln
 T 9
 Elog # 99

MISSISSIPPI
 BOARD OF WATER COMMISSIONERS
 416 North State Street
 Jackson, Mississippi 39201

CODED

WATER WELL DRILLERS LOG

June 1972 Griner Drilling Service Lincoln
 date well completed firm name county well located

LANDOWNER: #1 H.L.
WATSON, Watson Oil Co.
 Contractor (well No. 2)
 (mailing address)

description of fomations encountered	from	to
Top Soil	0	3
Gravel, Coarse	3	43
Clay	43	88
Sand with clay break	88	132
Clay with a few sand streaks	132	368
Sand, Fine*	368	430
Clay	430	776
Sand, Coarse	776	861

WELL LOCATION: 561 S. + Mo. Exp
 sec. 18 T Z (N) R 9 (E)
5 miles E of Brookhaven
 (distance) (direction) (nearest town)

WELL PURPOSE: Oil well supply
 (home, irrigation, municipal, industrial)

WELL COMPLETION DATA:

- (1) diameter (inches) 6 5/8
- (2) total depth (feet) 825
- (3) static water level (feet) 150 below
 top of ground.
- (4) casing B.I., 500'
 (material) (depth)
6 5/8 if telescope see back. 825-835
 (size)
- (5) screen 30', 825
 (length) (depth to top)
4" O.D., 304 S.S.
 (size) (material)
- (6) pump 10, 100
 (HP) (yield gpm)
Elect.
 (type power)
- (7) electric log Yes
 (yes or no)
MGS
 (organization running log)
- (8) how well bottom plugged Back
Wash pipe

CODED

DRILLERS REMARKS: Tried to
make well at 410' - failed to yield.



JUL 7 1972

20

If well telescopes please sketch and show depths.



GROUND LEVEL

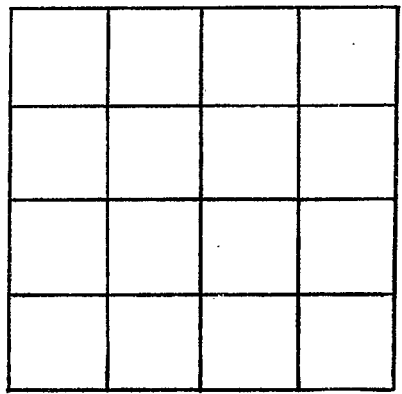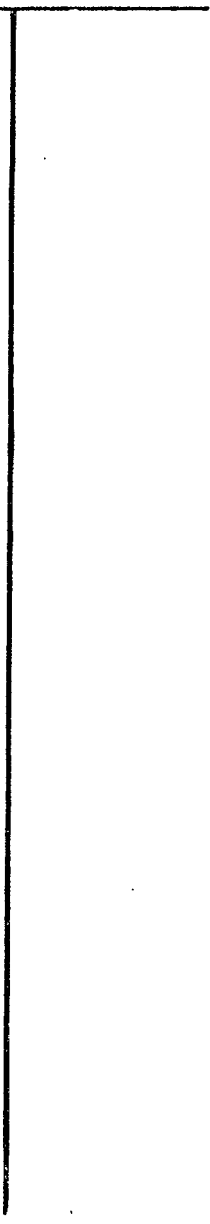

SECTION _____

Please indicate well location X.

ADDITIONAL INFORMATION

Lined area for additional information, consisting of multiple horizontal lines for text entry.

If more than one screen, show locations of each on sketch.