

LINCOLN

J10

8-17-73

MISSISSIPPI BOARD OF WATER COMMISSIONERS
416 North State Street
Jackson, Mississippi 39201

CODED

WATER WELL DRILLERS LOG

Aug 17 1973 Chester Keene Lincoln
date well completed firm name county well located

LANDOWNER: Betty Kaizer

description of formations encountered

from

to

H4
Brookhaven
(mailing address)

clay

0 19

Red sand

19 40

WELL LOCATION:

sand & gravel

40 63

sec 31 T 9 N R 9 E
8 miles SE Brookhaven
(distance) (direction) (nearest town)

hard blue chalk

63 119

WELL PURPOSE: Home
(home, irrigation, municipal, industrial)

Coarse sand

119 146

WELL COMPLETION DATA:

- (1) diameter (inches) 4"
- (2) total depth (feet) 146
- (3) static water level (feet) 87 below above top of ground.
- (4) casing Plast Ballant
(material) (depth)

(size) if telescope see back.

- (5) screen 6' 140'
(length) (depth to top)

4" Plast
(size) (material)

- (6) pump 3/4 HP 6
(HP) (yield gpm)

Steel
(type power)

- (7) electric log SP
(yes or no)

(organization running log)

- (8) how well bottom plugged wood plugs

DRILLERS REMARKS:
New location


CODED

RECORDED
JUL 30 1974

MISS. BD. OF WATER COMMISSIONERS

If well telescopes please sketch and show depths.

GROUND LEVEL

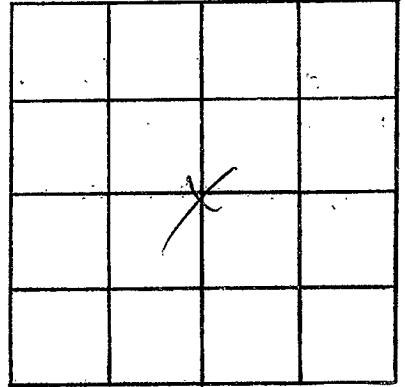

SECTION 31

Please indicate well location X.

ADDITIONAL INFORMATION

If more than one screen, show locations of each on sketch.