

MISSISSIPPI DEPARTMENT OF NATURAL RESOURCES

Bureau of Land and Water Resources

Southport Mall

P.O. Box 10631

Jackson, Mississippi 39209

WATER WELL DRILLERS LOG

CODED

Lincoln
J 11
4-6-81

Griner Drilling Service, Inc.

Lincoln

4-6-81
date well completed

Griner Drilling Service, Inc.
firm name

Lincoln
county well located

LANDOWNER:

Kilroy Company of Texas
1908 First City Natl. Bank
Houston, Texas 77002
(mailing address)

description of formations encountered

from

to

clay

0 410

sand

410 470

clay

470 476

WELL LOCATION: 2057'S + 500'E OF

sec. 10 T 9 S R 7 E NW 1/4

Glancy Field

(distance) (direction) (nearest town)

WELL PURPOSE: oil field supply
(home, irrigation, municipal, industry)

WELL COMPLETION DATA:

(1) diameter (inches) 3"

(2) total depth (feet) 476'

(3) static water level (feet) 150' below above
top of ground.

(4) casing steel, 462'
(material) (depth)

3"
(size) If telescope see back.

(5) screen 42', 420'
(length) (depth to top)

3", perforated
(size) (material)

(6) pump —, 75
(HP) (yield gpm)

AC
(type power)


(7) electric log —
(yes or no)

(organization running log)

(8) how well bottom plugged orange


peel

DRILLERS REMARKS:

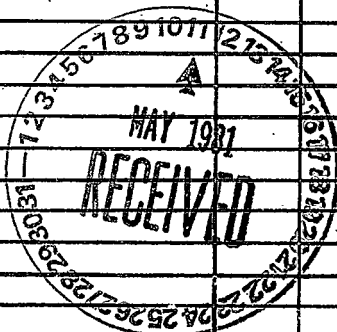

If well telescopes please sketch and show depths.

GROUND LEVEL

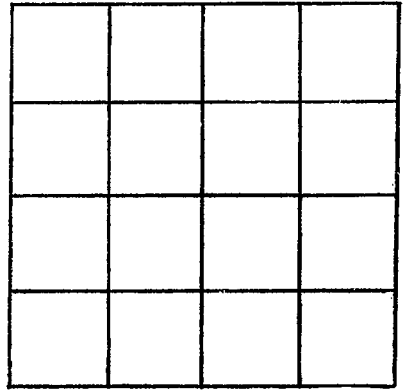

SECTION _____

Please indicate well location X.

ADDITIONAL INFORMATION

If more than one screen,
show locations of each on sketch.