

MISSISSIPPI DEPARTMENT OF NATURAL RESOURCES

Bureau of Land and Water Resources

Southport Mall

P.O. Box 10631

Jackson, Mississippi 39209

WATER WELL DRILLERS LOG

CODED

LINCOLN  
J 12

8-8

19 84

Green Water Well

Lincoln

date well completed

firm name

county well located

LANDOWNER:

Fair River Baptist Church  
Ball Park

c/o John Pennington

Rt. 1, Brookhaven, Ms.

(mailing address)

description of formations  
encountered

from

to

Clay

1

10

sand & gravel

10

23

white clay

23

28

blue clay

28

160

sand

160

178

WELL LOCATION:

sec. 26 T 7 N R 9 E  
S W

7 miles E of Brookhaven

(distance) (direction) (nearest town)

WELL PURPOSE: park

(home, irrigation, municipal, industrial)

CODED

WELL COMPLETION DATA:

- (1) diameter (inches) 4
- (2) total depth (feet) 178
- (3) static water level (feet) 40 below above top of ground.

(4) casing PVC 168  
(material) (depth)

4" if telescope see back.  
(size)

(5) screen 10' 168'  
(length) (depth to top)

.010 PVC  
(size) (material)

(6) pump did not install  
(HP) (yield gpm)

(type power)

(7) electric log no  
(yes or no)

(organization running log)

(8) how well bottom plugged  
back wash valve

DEPT. OF NATURAL RESOURCES  
BUREAU OF LAND & WATER RESOURCES


SEP 18 1984

RECEIVED

DRILLERS REMARKS:

If well telescopes please sketch and show depths.

GROUND LEVEL

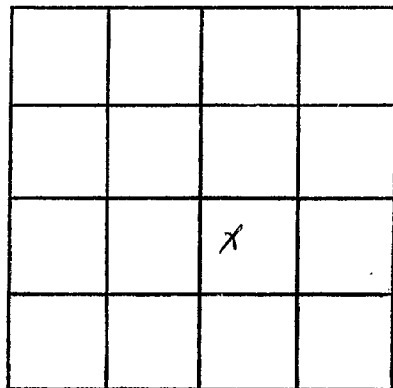

SECTION 26

Please indicate well location X.

ADDITIONAL INFORMATION

If more than one screen,  
show locations of each on sketch.