

Lincoln  
J 2000  
3-30-76


MISSISSIPPI  
 BOARD OF WATER COMMISSIONERS  
 416 North State Street  
 Jackson, Mississippi 39201

WATER WELL DRILLERS LOG

Mar. 30 1976 Grenn Water Well Con. Lincoln

date well completed firm name county well located

LANDOWNER:	description of formations encountered	from	to
Fair River Baptist Church	Clay	1	18
Route 1,	Gravel	18	30
Brookhaven, Miss.	Sand	30	42
(mailing address)	White clay	42	65
WELL LOCATION:	Blue clay	65	195
sec. 23 T 7 N R 9 E	fine sand	195	200
11 miles east Brookhaven	blue clay	200	260
(distance) (direction) (nearest town)	sand	260	270
WELL PURPOSE: home	Blue clay	270	275
(home, irrigation, municipal, industrial)	sand	275	290
WELL COMPLETION DATA:			
(1) diameter (inches) 4"			
(2) total depth (feet) 290			
(3) static water level (feet) 175 below top of ground			
(4) casing PVC 278 (material) (depth)			
4" (size) If telescope see back.			
(5) screen 12' 278 (length) (depth to top)			
.010 PVC (size) (material)			
(6) pump 1 hp sub. 10 (HP) (yield gpm)			
electricity (type power)			
(7) electric log no (yes or no)			
(organization running log)			
(8) how well bottom plugged wood			
DRILLERS REMARKS:			

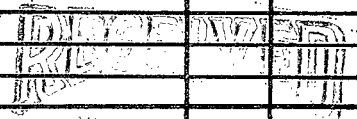

MAY 1976

MISS. BD. OF WATER

