

Lincoln
 J 2001
 3-24-77

MISSISSIPPI
 BOARD OF WATER COMMISSIONERS
 416 North State Street
 Jackson, Mississippi 39201

WATER WELL DRILLERS LOG

March 24 1977 Grenn Water Well Cont. Lincoln
 date well completed firm name county well located


| LANDOWNER: Harold Nations Route 1 | description of fomations encountered Citronelle | from 1 | to 95 |
|--|--|-----------|----------|
| Brookhaven, Miss. (mailing address) | | | |
| WELL LOCATION: sec 30 T 7 N R 9 E 6 miles E of Brookhaven (distance) (direction) (nearest town) | | | |
| WELL PURPOSE: home (home, irrigation, municipal, industrial) | | | |
| WELL COMPLETION DATA: | | | |
| (1) diameter (inches) 6 | | | |
| (2) total depth (feet) 95 | | | |
| (3) static water level (feet) 50 below top of ground. | | | |
| (4) casing PVC 83 (material) (depth) 4" if telescope see back. (size) | | | |
| (5) screen 12' 83' (length) (depth to top) | | | |
| .010 PVC (size) (material) | | | |
| (6) pump 1/2 sub 10 (HP) (yield gpm) | | | |
| electricity (type power) | | | |
| (7) electric log no (yes or no) | | | |
| (organization running log) | | | |
| (8) how well bottom plugged back wash valve | | | |
| DRILLERS REMARKS: | | | |

RECEIVED
 APR 22 1977

MISSISSIPPI BOARD OF WATER COMMISSIONERS

If well telescopes please sketch and show depths.

GROUND LEVEL

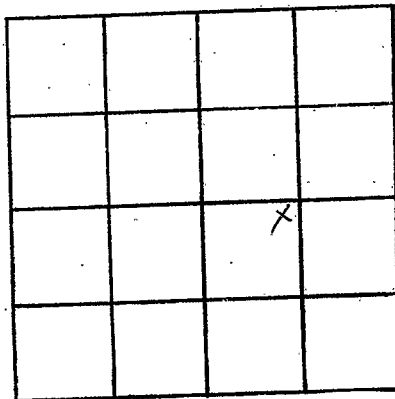

SECTION 30

Please indicate well location X.

ADDITIONAL INFORMATION

If more than one screen, show locations of each on sketch.