

LINCOLN
J
03-13-79
2005

**MISSISSIPPI
BOARD OF WATER COMMISSIONERS**
416 North State Street
Jackson, Mississippi 39201

WATER WELL DRILLERS LOG

March 13 19 79 Grenn Water Well Lincoln
 date well completed firm name county well located

LANDOWNER: Glen Hutcherson
 Route 1
 Brookhaven, Miss. 39601
 (mailing address)

description of formations encountered	from	to
clay & gravel	1	5
white clay	5	32
blue clay	32	209
sand	209	217

WELL LOCATION:
 sec. 23 T. 7 N j R. 9 E
 S W
 11 miles E of Brookhaven
 (distance) (direction) (nearest town)

WELL PURPOSE: home
 (home, irrigation, municipal, industrial)

WELL COMPLETION DATA:

(1) diameter (inches) 4

(2) total depth (feet) 217

(3) static water level (feet) 90 below above top of ground.

(4) casing PVC 205'
 (material) (depth)
 4" if telescope see back.
 (size)

(5) screen 12' 205'
 (length) (depth to top)
 .010 PVC
 (size) (material)

(6) pump 3/4 sub 10
 (HP) (yield gpm)
 electricity
 (type power)

(7) electric log no
 (yes or no)

(organization running log)


(8) how well bottom plugged backwash valve

DRILLERS REMARKS:

Miss. Board of Water Comm.
 MAY 9 1979
RECEIVED

If well telescopes please sketch and show depths.

GROUND LEVEL

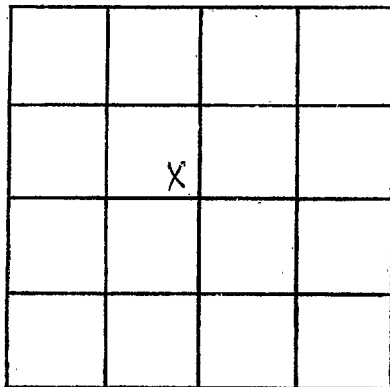

SECTION 23

Please indicate well location X.

ADDITIONAL INFORMATION

If more than one screen, show locations of each on sketch.