

LINCOLN
J
7/25/79
2007

**MISSISSIPPI  
BOARD OF WATER COMMISSIONERS  
416 North State Street  
Jackson, Mississippi 39201**

**WATER WELL DRILLERS LOG**

July 25 19 79 Grenn Water Well Cont. Lincoln  
 date well completed firm name county well located

LANDOWNER: Montrie Fugler  
Route 1  
Sontag, Miss.  
 (mailing address)

description of formations encountered	from	to
Clay	1	15
Sand & gravel	15	22
white clay	22	35
blue clay	35	165
sand	165	180

WELL LOCATION:  
 sec 23 T 7 N R 9 E  
   S  W  
10 miles E of Brookhaven  
 (distance) (direction) (nearest town)

WELL PURPOSE: home  
 (home, irrigation, municipal, industrial)

WELL COMPLETION DATA:

(1) diameter (inches) 4

(2) total depth (feet) 180

(3) static water level (feet) 65 below above top of ground.

(4) casing PVC 168'  
 (material) (depth)  
4"  
 (size) if telescope see back.

(5) screen 12' 168'  
 (length) (depth to top)  
.010 PVC  
 (size) (material)

(6) pump 3/4 sub 7 1/2  
 (HP) (yield gpm)  
electricity  
 (type power)

(7) electric log no  
 (yes or no)  
 (organization running log)


(8) how well bottom plugged Back wash valve

DRILLERS REMARKS:

Miss. Board of Water Comm.  
 AUG 16 1979  
**RECEIVED**

If well telescopes please sketch and show depths.

GROUND LEVEL

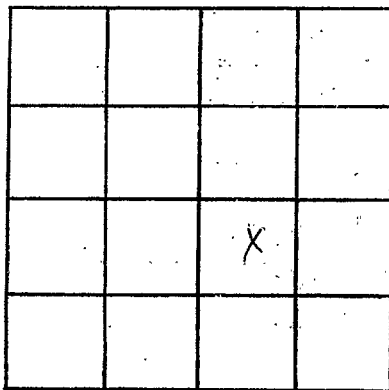

SECTION 23

Please indicate well location X.

ADDITIONAL INFORMATION

If more than one screen, show locations of each on sketch.