

Lincoln
 J
 2008
 11-9-79

MISSISSIPPI
 BOARD OF WATER COMMISSIONERS
 416 North State Street
 Jackson, Mississippi 39201

WATER WELL DRILLERS LOG

Nov. 9 1979 Grenn Water Well Cont. Lincoln

date well completed firm name county well located

LANDOWNER: Johnny Weeks

Rt. 1, Box 249 A

Sontag, Ms.

(mailing address)

WELL LOCATION:

sec. 24 T. 7 N. R. 9 E
 S W

10 miles E of Brookhaven
 (distance) (direction) (nearest town)

WELL PURPOSE: home
 (home, irrigation, municipal, industrial)

WELL COMPLETION DATA:

- (1) diameter (inches) 6
- (2) total depth (feet) 144
- (3) static water level (feet) 40 below top of ground.
- (4) casing PVC 134
 (material) (depth)
 4" if telescope see back.
 (size)
- (5) screen 10' 134
 (length) (depth to top)
 .010 PVC
 (size) (material)
- (6) pump 3/4 sub 10
 (HP) (yield gpm)
~~XXXX~~ electricity
 (type power)
- (7) electric log no
 (yes or no)

(organization running log)

(8) how well bottom plugged
 back wash valve

DRILLERS REMARKS:

description of formations encountered	from	to
Clay	1	10
sand & gravel	10	20
white clay	20	40
blue clay	40	120
sand	120	140


DEPT. OF NATURAL RESOURCES
 BUREAU OF LAND & WATER RESOURCES

NOV 20 1979

RECEIVED

If well telescopes please sketch and show depths.

GROUND LEVEL

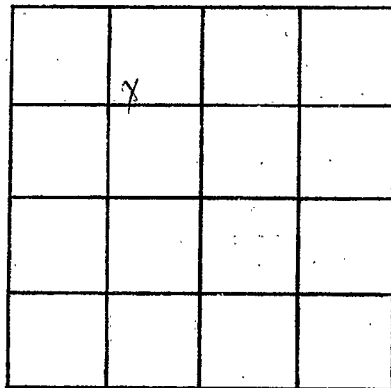

SECTION 24

Please indicate well location X.

ADDITIONAL INFORMATION

If more than one screen, show locations of each on sketch.