

Lincoln
 J 2010
 8-8-80

MISSISSIPPI
 BOARD OF WATER COMMISSIONERS
 416 North State Street
 Jackson, Mississippi 39201

WATER WELL DRILLERS LOG

Aug. 8 1980 Grenn Water Well Cont. Lincoln

date well completed


firm name

county well located

LANDOWNER:	description of formations encountered	from	to
Wesley White	clay	1	20
Route 1	white clay	20	40
Brookhaven, Ms.	blue clay	40	70
(mailing address)	fine sand	70	75
WELL LOCATION:	blue clay	75	235
sec. 27 T. 7 N. R. 9 E	sabd	235	259
8 miles E of Brookhaven			
(distance) (direction) (nearest town)			
WELL PURPOSE: home			
(home, irrigation, municipal, industrial)			
WELL COMPLETION DATA:			
(1) diameter (inches) 4			
(2) total depth (feet) 259			
(3) static water level (feet) 92 below top of ground.			
(4) casing PVC 249 (material) (depth)			
4" (size) If telescope see back.			
(5) screen 10' 249' (length) (depth to top)			
.010 PVC (size) (material)			
(6) pump did not install (HP) (yield gpm)			
(type power)			
(7) electric log no (yes or no)			
(organization running log)			
(8) how well bottom plugged backwash valve			
DRILLERS REMARKS:			

If well telescopes please sketch and show depths.

GROUND LEVEL

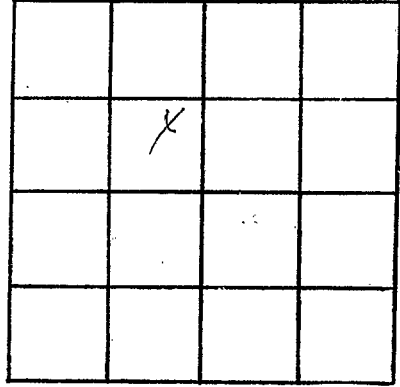

SECTION 27

Please indicate well location X.

ADDITIONAL INFORMATION

If more than one screen, show locations of each on sketch.