

**MISSISSIPPI DEPARTMENT OF NATURAL RESOURCES**  
**Bureau of Land and Water Resources**  
 Southport Mall  
 P.O. Box 10631  
 Jackson, Mississippi 39209  
**WATER WELL DRILLERS LOG**

Lincoln  
J  
2012

Mar. 18 1982 Gretn Water Well Lincoln  
 date well completed firm name county well located

LANDOWNER: <u>Bill Warren</u>	description of formations encountered	from	to
Route <u>1</u>			
<u>Brookhaven, Miss.</u> (mailing address)	Clay	1	10
	sand & gravel	10	25
	white clay	25	55
	blue clay	55	90
	white clay	90	120
	sand	120	180
<b>WELL LOCATION:</b> sec. <u>32</u> T <u>7</u> N R <u>9</u> E S W			
<u>7</u> miles <u>SSE</u> of <u>Brookhaven</u> (distance) (direction) (nearest town)			
<b>WELL PURPOSE:</b> <u>home</u> (home, irrigation, municipal, industrial)			
<b>WELL COMPLETION DATA:</b>			
(1) diameter (inches) <u>4</u>			
(2) total depth (feet) <u>180</u>			
(3) static water level (feet) <u>105</u> below top of ground.			
(4) casing <u>pvc</u> <u>170</u> (material) (depth) <u>4"</u> (size) if telescope see back.			
(5) screen <u>10</u> ; <u>170'</u> (length) (depth to top) <u>.010</u> <u>PVC</u> (size) (material)			
(6) pump <u>1/2</u> sub <u>8</u> (HP) (yield gpm) <u>electricity</u> (type power)			
(7) electric log <u>no</u> (yes or no) <u>(organization running log)</u>			
(8) how well bottom plugged <u>back wash valve</u>			

DRILLERS REMARKS: \_\_\_\_\_


DEPT. OF NATURAL RESOURCES  
 BUREAU OF LAND & WATER RESOURCES

MAY 10 1982

**RECEIVED**

If well telescopes please sketch and show depths.

GROUND LEVEL

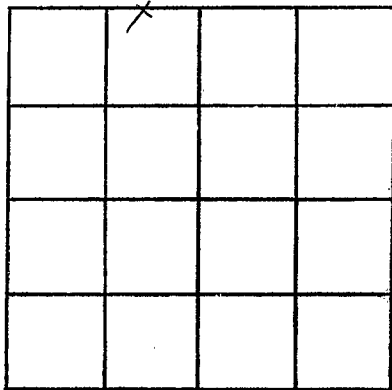

SECTION 32

Please indicate well location X.

ADDITIONAL INFORMATION

If more than one screen,  
show locations of each on sketch.