

Lincoln
J 2014

MISSISSIPPI DEPARTMENT OF NATURAL RESOURCES
 Bureau of Land and Water Resources
 Southport Mall
 P.O. Box 10631
 Jackson, Mississippi 39209
WATER WELL DRILLERS LOG

Sept. 13 19 82 Grenn Water Well Lincoln
 date well completed firm name county well located

LANDOWNER: Jerry Nations	description of formations encountered	from	to
Route 1			
Brookhaven, Ms.	sand & gravel	20	55
(mailing address)	white clay	55	100
	sand	100	140

WELL LOCATION:
 sec. 30 T 7 N R 9 E
 S W
 5 miles East of Brookhaven
 (distance) (direction) (nearest town)


WELL PURPOSE: home
 (home, irrigation, municipal, industrial)

- WELL COMPLETION DATA:**
- (1) diameter (inches) 4
 - (2) total depth (feet) 140
 - (3) static water level (feet) 70 below above top of ground.
 - (4) casing PVC, 120
 (material) (depth)
4" if telescope see back.
 (size)
 - (5) screen 20", 120"
 (length) (depth to top)
.010, PVC
 (size) (material)
 - (6) pump 1/2 sub 8
 (HP) (yield gpm)
electricity
 (type power)
 - (7) electric log no
 (yes or no)
(organization running log)
 - (8) how well bottom plugged
back wash valve

DRILLERS REMARKS:
 NOV 23 1982
RECEIVED

If well telescopes please sketch and show depths.

GROUND LEVEL

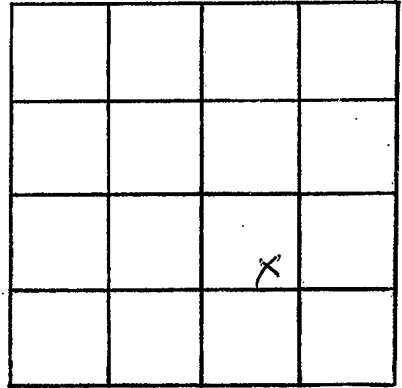

SECTION 30

Please indicate well location X.

ADDITIONAL INFORMATION

If more than one screen,
show locations of each on sketch.