

Lincoln
9
2015

MISSISSIPPI
 BOARD OF WATER COMMISSIONERS
 416 North State Street
 Jackson, Mississippi 39201

WATER WELL DRILLERS LOG

8-30 date well completed 1982 Fitzgerald & Son firm name Lincoln county well located

LANDOWNER:	description of formations encountered	from	to
<u>Assem Zeini</u>			
<u>R.R. Breaker ms.</u> (mailing address)	<u>Red Clay</u> <u>Red Sand</u> <u>Coarse sand & gravel</u>	<u>0</u> <u>20</u> <u>60</u>	<u>20</u> <u>60</u> <u>88</u>
WELL LOCATION:			
sec. <u>38</u> T <u>2</u> N R <u>9</u> E S W <u>2</u> miles <u>SE</u> of <u>Boak</u> (distance) (direction) (nearest town)			
WELL PURPOSE: (home, irrigation, municipal, industrial)			
WELL COMPLETION DATA:			
(1) diameter (inches) <u>4</u>			
(2) total depth (feet) <u>88</u>			
(3) static water level (feet) <u>60</u> below above top of ground.			
(4) casing <u>PVC</u> , <u>80</u> , (material) (depth) <u>4</u> if telescope see back. (size)			
(5) screen <u>8</u> , <u>80</u> (length) (depth to top) <u>4</u> , <u>PVC</u> (size) (material)			
(6) pump <u>1/2</u> , <u>10</u> (HP) (yield gpm) <u>Elco</u> (type power)			
(7) electric log <u>no</u> (yes or no)			
(8) how well bottom plugged <u>See sketch</u>			
DRILLERS REMARKS:			


DEPT. OF NATURAL RESOURCES
 BUREAU OF LAND & WATER RESOURCES

OCT 18 1982

RECEIVED

If well telescopes please sketch and show depths.

GROUND LEVEL

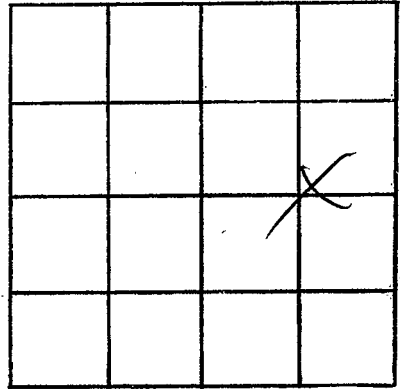

SECTION 28

Please indicate well location X.

ADDITIONAL INFORMATION

A series of horizontal lines for writing additional information, consisting of 18 lines.

If more than one screen, show locations of each on sketch.