

Lincoln
 8
 2018

MISSISSIPPI DEPARTMENT OF NATURAL RESOURCES
 Bureau of Land and Water Resources
 Southport Mall
 P.O. Box 10631
 Jackson, Mississippi 39209
WATER WELL DRILLERS LOG

May 9 19 83 Grenn Water Well Lincoln
 date well completed firm name county well located

LANDOWNER: Danny Lofton	description of formations encountered	from	to
Route 2, Box 140	Clay	1	5
	white clay	5	20
(mailing address)	blue clay	20	170
	sand	170	189
WELL LOCATION:			
sec. <u>22</u> T <u>7</u> N R <u>9</u> E S W			
9 miles E of Brookhaven (distance) (direction) (nearest town)			
WELL PURPOSE: home (home, irrigation, municipal, industrial)			
WELL COMPLETION DATA:			
(1) diameter (inches) <u>4</u>			
(2) total depth (feet) <u>189</u>			
(3) static water level (feet) <u>80</u> below top of ground. above			
(4) casing <u>PVC</u> <u>179</u> (material) (depth)			
<u>4"</u> If telescope see back. (size)			
(5) screen <u>10'</u> <u>179'</u> (length) (depth to top)			
<u>.010</u> <u>PVC</u> (size) (material)			
(6) pump <u>did not install</u> (HP) (yield gpm)			
(type power)			
(7) electric log <u>no</u> (yes or no)			
(organization running log)			
(8) how well bottom plugged			
<u>back wash valve</u>			
DRILLERS REMARKS:			


DEPT. OF NATURAL RESOURCES
 BUREAU OF LAND & WATER RESOURCES

AUG 30 1983

RECEIVED

If well telescopes please sketch and show depths.

GROUND LEVEL

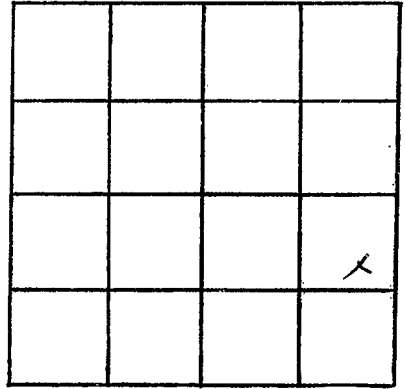

SECTION 22

Please indicate well location X.

ADDITIONAL INFORMATION

If more than one screen,
show locations of each on sketch.