

Lenoir
J
2021

MISSISSIPPI DEPARTMENT OF NATURAL RESOURCES
 Bureau of Land and Water Resources
 Southport Mall
 P.O. Box 10631
 Jackson, Mississippi 39209
WATER WELL DRILLERS LOG

Nov. 8 1983 Grenn Water Well Lincoln
 date well completed firm name county well located

LANDOWNER: <u>Murray Varnado</u>	description of formations encountered	from	to
<u>Route 1</u>			
<u>Brookhaven, Ms.</u>	<u>White clay</u>	<u>5</u>	<u>30</u>
<u>(mailing address)</u>	<u>blue clay</u>	<u>30</u>	<u>240</u>
	<u>Sand</u>	<u>240</u>	<u>255</u>

WELL LOCATION:
 sec 27 T 7 N R 9 E
 S W
8 miles SE of Brookhaven
 (distance) (direction) (nearest town)

WELL PURPOSE: Home
 (home, irrigation, municipal, industrial)

- WELL COMPLETION DATA:
- (1) diameter (inches) 4
 - (2) total depth (feet) 255
 - (3) static water level (feet) 92 below above top of ground.
 - (4) casing PVC 245
 (material) (depth)
4"
 (size) if telescope see back.
 - (5) screen 10' 245'
 (length) (depth to top)
.010 PVC
 (size) (material)
 - (6) pump 3/4 sub. 10
 (HP) (yield gpm)
electricity
 (type power)
 - (7) electric log no
 (yes or no)
(organization running log)

(8) how well bottom plugged back wash valve

DRILLERS REMARKS:


DEPT. OF NATURAL RESOURCES
 BUREAU OF LAND & WATER RESOURCES

MAR -7 1984

RECEIVED

If well telescopes please sketch and show depths.

GROUND LEVEL

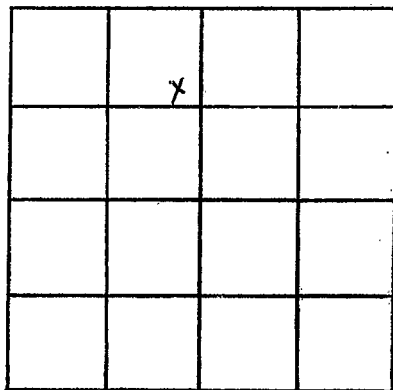

SECTION 27

Please indicate well location X.

ADDITIONAL INFORMATION

If more than one screen,
show locations of each on sketch.