

**MISSISSIPPI DEPARTMENT OF NATURAL RESOURCES**  
**Bureau of Land and Water Resources**  
 Southport Mall  
 P.O. Box 10631  
 Jackson, Mississippi 39209  
**WATER WELL DRILLERS LOG**

*Lincoln*  
 8  
 2022


4-20-84, Grenn Water Well Lincoln  
 date well completed firm name county well located

LANDOWNER: <u>Larry Delaughter</u> <u>Rt. 1, Box 359</u>	description of formations encountered	from	to
<u>Brookhaven, Ms.</u> (mailing address)	<u>Citronelle</u>	<u>1</u>	<u>70</u>
<b>WELL LOCATION:</b>			
sec. <u>28</u> T <u>7</u> N R <u>9</u> E S W <u>6</u> miles <u>E</u> of <u>Brookhaven</u> (distance) (direction) (nearest town)			
<b>WELL PURPOSE:</b> <u>home</u> (home, irrigation, municipal, industrial)			
<b>WELL COMPLETION DATA:</b>			
(1) diameter (inches) <u>4</u>			
(2) total depth (feet) <u>70</u>			
(3) static water level (feet) <u>34</u> below above top of ground.			
(4) casing <u>PVC</u> <u>60'</u> (material) (depth) <u>4"</u> (size) if telescope see back.			
(5) screen <u>10'</u> <u>60'</u> (length) (depth to top) <u>4"</u> <u>PVC</u> (size) (material)			
(6) pump <u>did not install</u> (HP) (yield gpm)  (type power)			
(7) electric log <u>RD</u> (yes or no)  (organization running log)			
(8) how well bottom plugged <u>back wash valve</u>			
<b>DRILLERS REMARKS:</b>			

DEPT. OF NATURAL RESOURCES  
 BUREAU OF LAND & WATER  
 RECEIVED JUN 11 1984

If well telescopes please sketch and show depths.

GROUND LEVEL

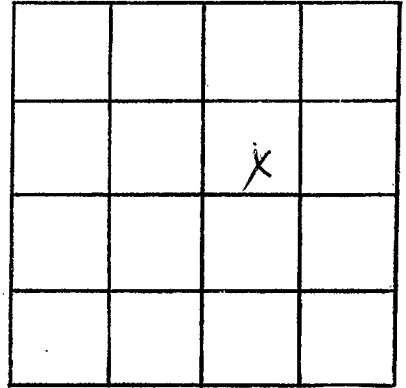

SECTION 28

Please indicate well location X.

ADDITIONAL INFORMATION

If more than one screen,  
show locations of each on sketch.