

Lincoln  
J  
2023

MISSISSIPPI DEPARTMENT OF NATURAL RESOURCES  
 Bureau of Land and Water Resources  
 Southport Mall  
 P.O. Box 10631  
 Jackson, Mississippi 39209  
**WATER WELL DRILLERS LOG**

July 6 19 84 Grenn Water Well Lincoln  
 date well completed firm name county well located

LANDOWNER: Raymond Grimes  
 description of formations encountered  
 Route 1 Citronelle from 1 to 78  
 Brookhaven, Ms.  
 (mailing address)

WELL LOCATION:  
 sec 33 T 7 N R 9 E  
 S W  
5 miles E of Brookhaven  
 (distance) (direction) (nearest town)

WELL PURPOSE: home  
 (home, irrigation, municipal, industrial)

- WELL COMPLETION DATA:
- (1) diameter (inches) 4"
  - (2) total depth (feet) 78'
  - (3) static water level (feet) 25 below above top of ground.
  - (4) casing PVC 68'  
 (material) (depth)  
4" if telescope see back.  
 (size)
  - (5) screen 10' 68'  
 (length) (depth to top)  
.010 PVC  
 (size) (material)
  - (6) pump 1/2 sub 8  
 (HP) (yield gpm)  
electricity  
 (type power)
  - (7) electric log no  
 (yes or no)  
 (organization running log)
  - (8) how well bottom plugged back wash valve

DRILLERS REMARKS:


DEPT. OF NATURAL RESOURCES  
 BUREAU OF LAND & WATER RESOURCES

SEP 12 1984

RECEIVED

If well telescopes please sketch and show depths.

GROUND LEVEL

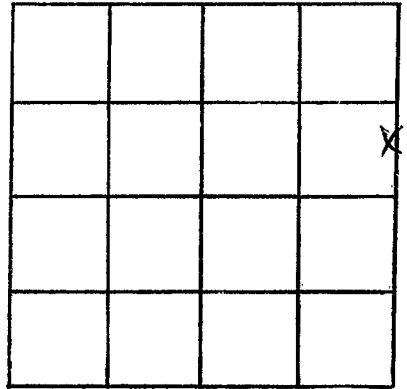

SECTION 33

Please indicate well location X.

ADDITIONAL INFORMATION

If more than one screen,  
show locations of each on sketch.