

MISSISSIPPI DEPARTMENT OF NATURAL RESOURCES

Bureau of Land and Water Resources

Southport Mall

P.O. Box 10631

Jackson, Mississippi 39209

WATER WELL DRILLERS LOG

Lincoln
2026

9-24-

1984

Grenn Water Well

Lincoln

date well completed

firm name

county well located,

LANDOWNER: Brookhaven

Bank & Trust Co.

Brookhaven, Ms.

(mailing address)

WELL LOCATION:

sec. 22 T 7 N S

R 9 E W

8

miles

E

(distance) (direction)

Brook-
haven

(nearest town)

WELL PURPOSE: home

(home, irrigation, municipal, industrial)

WELL COMPLETION DATA:

- (1) diameter (inches) 4
- (2) total depth (feet) 190
- (3) static water level (feet) 85 below above top of ground.
- (4) casing PVC 170'
(material) (depth)
4"
(size) if telescope see back.
- (5) screen 20' 170'
(length) (depth to top)
.010 PVC
(size) (material)
- (6) pump 1/2 Sub 8
(HP) (yield gpm)
electricity
(type power)
- (7) electric log no
(yes or no)

(organization running log)

- (8) how well bottom plugged back wash valve

DRILLERS REMARKS:

description of formations encountered

from

to

White clay	1	30
Blue Clay	30	80
Sand	80	90
Blue Clay	90	170
Sand	170	173
Blue Clay	173	175
Sand	175	180
Blue Clay	180	185
Sand	185	190


DEPT. OF NATURAL RESOURCES
BUREAU OF LAND & WATER RESOURCES

NOV 15 1984

RECEIVED

If well telescopes please sketch and show depths.

GROUND LEVEL

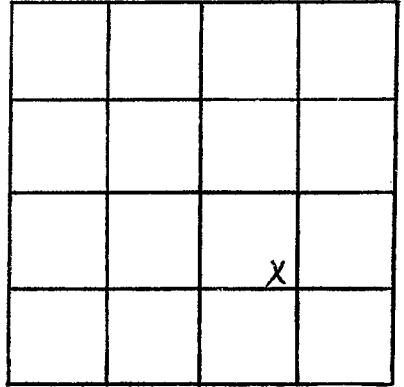

SECTION 22

Please indicate well location X.

ADDITIONAL INFORMATION

If more than one screen,
show locations of each on sketch.