

**MISSISSIPPI DEPARTMENT OF ENVIRONMENTAL QUALITY**  
Bureau of Land and Water Resources

P. O. Box 10631  
Jackson, MS 39289-0631  
**WATER WELL DRILLERS LOG**

COUNTY WELL LOCATED <b>Lincoln</b>	
WELL NUMBER <b>J 2043</b>	CODED
DATE WELL COMPLETED <b>8-11-93</b>	

PERMIT NUMBER
NAME OF DRILLING FIRM <b>Green Water Well &amp; Supply</b>

NAME & MAILING ADDRESS OF LANDOWNER <b>James Garno</b>		
<b>Rt. 1 Box 368</b>		
<b>Brookhaven MS 39601</b>		
WELL LOCATION: SEC	TOWNSHIP	RANGE
<b>210</b>	<b>7</b>	<b>9</b>
	<b>N</b>	<b>E</b>
	<b>S</b>	<b>W</b>
DISTANCE	DIRECTION	NEAREST TOWN
<b>6</b> Miles	<b>E</b>	<b>of Brookhaven</b>
OTHER LANDMARK		
WELL PURPOSE: <input checked="" type="checkbox"/> Home Irrigation, <input type="checkbox"/> Municipal, <input type="checkbox"/> Industrial, <input type="checkbox"/> Fish Pond, etc.		

<b>PUMP DATA</b>		
PUMP TYPE (Circle One): <input checked="" type="checkbox"/> Submersible Turbine, Jet, Flowing Well, Other (Describe) _____		
POWER TYPE (Circle One): <input checked="" type="checkbox"/> Electric Tractor, Diesel, Gasoline, $\frac{1}{2}$ Butane, Other (Describe) _____ H/P $\frac{1}{2}$		
Pump Capacity (GPM) <b>10</b>	No. of Stages <b>9</b>	Setting Depth <b>102</b> FT.
PUMP TEST		
Well yielded <b>10</b> GPM with a drawdown of <b>0</b> ft. after <b>1</b> hours of pumping		

<b>WELL DATA</b>		
Well Depth <b>113</b>	Casing Diameter (In.) <b>4 in</b>	Casing Length (Ft.) <b>103</b>
Type of Casing <b>PVC</b>	Hole Depth <b>120</b>	Depth to Static Water Level <b>75</b>
TYPE OF COMPLETION: (Circle One or More): <input checked="" type="checkbox"/> Gravel Packed, <input type="checkbox"/> Underreamed, <input type="checkbox"/> Telescoped, <input type="checkbox"/> Natural Development, <input type="checkbox"/> Open Hole, <input type="checkbox"/> Other (Describe) _____		
Top of Lap Pipe or Reduction in Casing <b>FEET</b> IF TELESCOPED OR MORE THAN ONE SCREEN: USE BACK PAGE		

<b>LOG DATA</b>	
TYPE OF LOG RUN (Circle One): Electric, Gamma Ray, Density, Sonic, Neutron, Other (Describe) _____ <input checked="" type="checkbox"/> No Log Run	
Name of Organization Running Log	


<b>SCREEN DATA</b>		
Diameter - Inches <b>4 in</b>	Length - Feet <b>10 ft.</b>	Slot Size - Inches <b>.010</b>
Screen Type <b>PVC</b>	Depth to Bottom - Feet <b>113</b>	

<b>GEOLOGIC DATA (Office Use Only)</b>			
Surface Elev.	Geologic Unit	Unit Thickness	Depth to Top
Subs. SWL	Date	Analysis	Aquifer Test
Driller's Remarks			

DESCRIPTION OF FORMATIONS ENCOUNTERED	FROM	TO	FORMATIONS (Continued)	FROM	TO
<b>Red Clay w/ Sand &amp; Gravel</b>	<b>0</b>	<b>20</b>	<b>DISCLOSED</b>		
<b>White Clay</b>	<b>20</b>	<b>67</b>			
<b>Sand</b>	<b>67</b>	<b>120</b>			
			<b>JUL 01 1994</b>		
			Dept. of Environmental Quality Office of Land & Water Resources		
			IF MORE SPACE IS NEEDED, USE BACK		

If well telescopes please sketch and show depths.

GROUND LEVEL

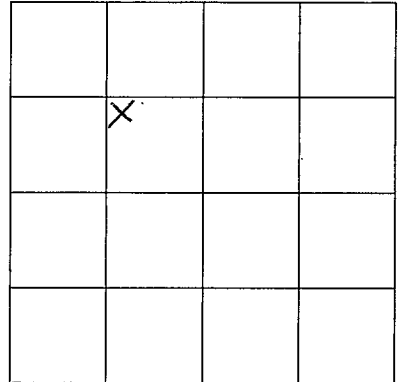

SECTION 20

Please indicate well location X.

ADDITIONAL INFORMATION

If more than one screen,  
show location of each on sketch.