

**MISSISSIPPI DEPARTMENT OF ENVIRONMENTAL QUALITY**

Office of Land and Water Resources

P. O. Box 10631  
Jackson, MS 39289-0631  
**WATER WELL DRILLERS LOG**

COUNTY WELL LOCATED <u>Lincoln</u>	
WELL NUMBER <u>J 2062</u>	CODED
DATE WELL COMPLETED <u>12-6-98</u>	

GREENHAWK <b>Green Water Well &amp; Supply</b> 1318 Pinedale Dr. SE Bogue Chitto, MS 39629
---

NAME & MAILING ADDRESS OF LANDOWNER <u>Wey Summers</u>		
<u>0416 Summers Ln SE</u>		
<u>Brookhaven, MS</u>		
WELL LOCATION:	SEC	TOWNSHIP RANGE
	<u>33</u>	<u>7</u> <sup>N</sup> <sub>S</sub> <u>9</u> <sup>E</sup> <sub>W</sub>
DISTANCE	DIRECTION	NEAREST TOWN
<u>2</u> Miles	<u>SW</u>	of <u>Fair River</u>
OTHER LANDMARK		
WELL PURPOSE (Home) Irrigation, Municipal, Industrial, Fish Pond, etc.		

PUMP DATA		
PUMP TYPE (Circle One): <u>Submersible</u> Turbine Jet Flowing Well, Other (Describe) _____		
POWER TYPE (Circle One): <u>Electric</u> Tractor Diesel Gasoline <sup>1</sup> / <sub>2</sub> Butane, Other (Describe) _____ H/P <u>1/2</u>		
Pump Capacity (GPM) <u>10</u>	No. of Stages <u>9</u>	Setting Depth <u>70</u> FT.
PUMP TEST		
Well yielded <u>10</u> GPM with a drawdown of <u>0</u> ft. after <u>1</u> hours of pumping		

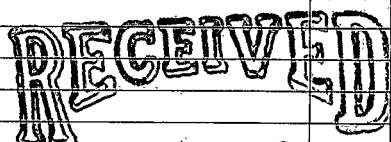
WELL DATA		
Well Depth <u>95'</u>	Casing Diameter (In.) <u>4"</u>	Casing Length (Ft.) <u>75'</u>
Type of Casing <u>PVC</u>	Hole Depth <u>106'</u>	Depth to Static Water Level <u>38'</u>
TYPE OF COMPLETION: (Circle One or More): <u>Gravel Packed</u> Underreamed Telescoped, Natural Development, Open Hole, Other (Describe) _____		
WELL GROUTED TO A DEPTH OF <u>10</u> FEET Type Grout (circle one): Cement, Bentonite, or <u>Mix</u>		

LOG DATA	
TYPE OF LOG RUN (Circle One): Electric, Gamma Ray, Density, Sonic, <u>No Log Run</u> , Neutron, Other (Describe) _____	
Name of Organization Running Log	

SCREEN DATA		
Diameter - Inches <u>4"</u>	Length - Feet <u>20'</u>	Slot Size - Inches <u>.010</u>
Screen Type <u>PVC</u>	Depth to Bottom - Feet <u>98'</u>	

GEOLOGIC DATA (Office Use Only)			
Surface Elev.	Geologic Unit	Unit Thickness	Depth to Top
Subs. SWL	Date	Analysis	Aquifer Test
Driller's Remarks			
Top of Lap Pipe or Reduction in Casing			
FEET		IF TELESCOPED OR MORE THAN ONE SCREEN: USE BACK PAGE	

DESCRIPTION OF FORMATIONS ENCOUNTERED	FROM	TO
Red Clay	0	18
White Clay	18	33
Sand	33	49
Blue Clay	49	57
Sand/Gravel	57	82
Sand w/ Clay Streets	82	106

FORMATIONS (Continued)	FROM	TO
 JAN 25 1999 Dept of Environmental Quality Office of Land & Water Resources		

IF MORE SPACE IS NEEDED, USE BACK

If well telescopes please sketch and show depths.

GROUND LEVEL

X			

SECTION 33

Please indicate well location X.

ADDITIONAL INFORMATION

If more than one screen,  
show location of each on sketch.