

MISSISSIPPI DEPARTMENT OF ENVIRONMENTAL QUALITY

Office of Land and Water Resources

P. O. Box 10631
Jackson, MS 39289-0631
WATER WELL DRILLERS LOG

COUNTY WELL LOCATED <i>Lumbard</i>	
WELL NUMBER <i>I 2063</i>	CODED
DATE WELL COMPLETED <i>3-6-99</i>	

Green Water Well & Supply
1318 Pricedale Dr. SE
Bogue Chitto, MS 39629

NAME & MAILING ADDRESS OF LANDOWNER <i>Mike Warren / Auel Co</i>		
<i>2724 Warren Rd SE</i>		
<i>Brookhaven</i>		
WELL LOCATION: SEC	TOWNSHIP	RANGE
<i>32</i>	<i>1 N</i>	<i>9 E</i>
DISTANCE	DIRECTION	NEAREST TOWN
<i>6</i> Miles	<i>SE</i>	of <i>Brookhaven</i>
OTHER LANDMARK		
WELL PURPOSE: <input checked="" type="checkbox"/> Home, <input type="checkbox"/> Irrigation, <input type="checkbox"/> Municipal, <input type="checkbox"/> Industrial, <input type="checkbox"/> Fish Pond, etc.		

PUMP DATA		
PUMP TYPE (Circle One): <input checked="" type="checkbox"/> Submersible, <input type="checkbox"/> Turbine, <input type="checkbox"/> Jet, <input type="checkbox"/> Flowing Well, Other (Describe) _____		
POWER TYPE (Circle One): <input checked="" type="checkbox"/> Electric, <input type="checkbox"/> Tractor, <input type="checkbox"/> Diesel, <input type="checkbox"/> Gasoline, <input type="checkbox"/> Butane, Other (Describe) _____ H/P <i>3/4</i>		
Pump Capacity (GPM) <i>10</i>	No. of Stages <i>12</i>	Setting Depth <i>135</i> FT.
PUMP TEST		
Well yielded <i>10</i> GPM with a drawdown of <i>0</i> ft. after <i>1</i> hours of pumping		

WELL DATA		
Well Depth <i>170'</i>	Casing Diameter (In.) <i>4"</i>	Casing Length (Ft.) <i>160'</i>
Type of Casing <i>PVC</i>	Hole Depth <i>180</i>	Depth to Static Water Level <i>103'</i>
TYPE OF COMPLETION: (Circle One or More): <input checked="" type="checkbox"/> Gravel Packed, <input type="checkbox"/> Underreamed, <input type="checkbox"/> Telescoped, <input type="checkbox"/> Natural Development, <input type="checkbox"/> Open Hole, <input type="checkbox"/> Other (Describe) _____		
WELL GROUTED TO A DEPTH OF <i>10</i> FEET Type Grout (circle one): Cement, Bentonite, or <i>Mix</i>		

LOG DATA	
TYPE OF LOG RUN (Circle One): Electric, Gamma Ray, Density, Sonic, <input checked="" type="checkbox"/> No Log Run, Neutron, Other (Describe) _____	
Name of Organization Running Log	

SCREEN DATA		
Diameter - Inches <i>4"</i>	Length - Feet <i>10'</i>	Slot Size - Inches <i>.010</i>
Screen Type <i>PVC</i>	Depth to Bottom - Feet <i>170'</i>	

GEOLOGIC DATA (Office Use Only)			
Surface Elev.	Geologic Unit	Unit Thickness	Depth to Top
Subs. SWL	Date	Analysis	Aquifer Test
Driller's Remarks			
Top of Lap Pipe or Reduction in Casing			
FEET		IF TELESCOPED OR MORE THAN ONE SCREEN: USE BACK PAGE	


DESCRIPTION OF FORMATIONS ENCOUNTERED	FROM	TO
Red Clay	0	20
Sand / Gravel	20	45
Red Clay	45	50
White Clay	50	68
Blue Clay	68	135
Sand	135	180

FORMATIONS (Continued)	FROM	TO
RECEIVED		
JUN 28 1999		
Dept of Environmental Quality Office of Land & Water Resources		

IF MORE SPACE IS NEEDED, USE BACK

If well telescopes please sketch and show depths.

GROUND LEVEL

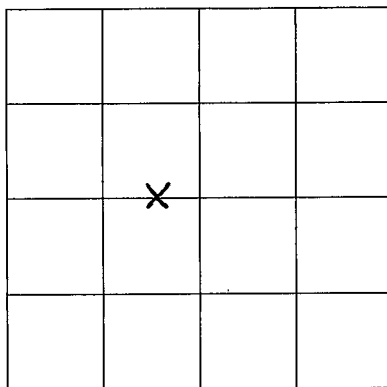

SECTION 32

Please indicate well location X.

ADDITIONAL INFORMATION

If more than one screen, show location of each on sketch.