

LINCOLN MISSISSIPPI BOARD OF WATER COMMISSIONERS

K1

WATER WELL DRILLERS LOG

H-300

7-25-60 CODED

Date: 7-25, 1960, Driller: Chester Reeves County LINCOLN

Reeves Well & Pump Co. (Name)

(1) Owner of Land: Wesley Smith (Name)

RED 5 Barrow Brookhaven (Address)

(2) Location: 1/4, 1/4, Sec 20-66 T-3 R-3, 15 miles S.E.W. of Brookhaven (distance) (direction) (Nearest Town)

(3) Topography: 4.44 (Hilly) (Flat) (Level)

(4) Purpose of Well: Domestic (Domestic Irrigation Municipal, Industrial, Other)

Description & Color of Materials Sand, Clay, Red Clay, Shell, etc.	Thickness Feet	Depth Feet
Clay	30	20
Sand & pipe clay	35	55
Clay	125	180
Fine Sand	30	210
medium coarse sand	23	233
	238	

Information upon completion of well:

(1) Diameter: 2 inches.

(2) Total Depth: 233 feet.

(3) Water Level: 160 feet below top of ground.

(4) Cased to Bottom Size 2"

(5) Screen: Size 1 1/4", Length 6'


(6) Were any formations sealed against pollution?

yes, / no.

If YES depth of formation.

Why

Drillers Remarks:

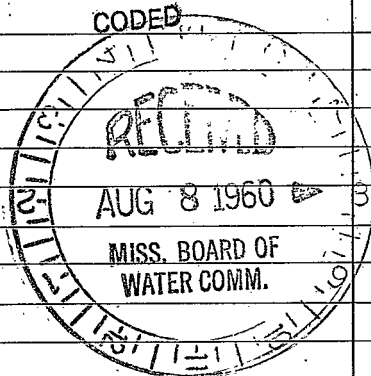

(Use Back Side)

Well No.

Date	Particulars	Debit	Credit