

LINCOLN

MISSISSIPPI BOARD OF WATER COMMISSIONERS

K3

8600 9748

CODED

11-27-63

CODED WATER WELL DRILLERS LOG

Date: 11/27, 1963, Driller: Roy A. Chandridge County Lincoln


(Name)

(1) Owner of Land: Louis Byrd
 (Name)
8 West Circle Drive
VIDALIA LA
 (Address) ~~24 26~~
B 6 6
 (2) Location: $\frac{1}{4}$, $\frac{1}{4}$, Sec. 3 T. 6 R. 6
 Located on 24 highway
10 miles West of
 (distance) (direction) (Nearest Town)
BROOKHAVE
 (3) Topography: (Hilly) (Flat) (Level)
 (4) Purpose of Well: (X)
 (Domestic Irrigation
 Municipal, Industrial, Other)

Description & Color of Materials Sand, Clay, Red Clay, Shell, etc.	Thick- ness Feet	Depth Feet
<u>yellow clay</u>	<u>18</u>	<u>18</u>
<u>Sand & Gravel</u>	<u>2</u>	<u>2</u>
<u>Gray pipe clay</u>	<u>20</u>	<u>20</u>
<u>with traces of Red pipe clay</u>		

Information upon completion of well:

(1) Diameter 24" inches. ID
 (2) Total Depth 40 feet.
 (3) Water level 18 feet below top of ground.
 (4) Cased to 40', Size 24"
 (5) Screen: Size NONE, Length —
 (6) Were any formations sealed against pollution?
will seal w/ cement
yes no. 24"

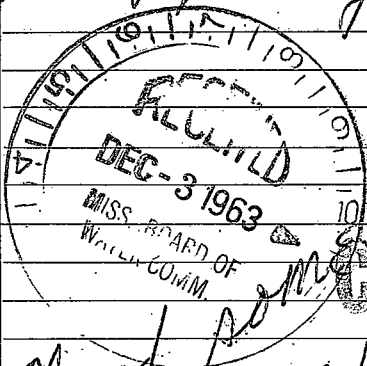

CODED

Need to see
 envelopes
 and another
 pad forms

If YES depth of formation _____
 Why Keep out surface
 (rain) water
 Drillers' Remarks:
well filled w/ clear
 water
 in about 3 hours
517 GALLONS ON DEMAND

(Use Back Side)

Well No.

