

LINCOLN MISSISSIPPI BOARD OF WATER COMMISSIONERS

K4

12-22-65 ⁶⁵ WEDDED WATER WELL DRILLERS LOG

Date: 12-22, 1965, Driller: J. T. Cozmon & Son County Pike
(Name)

(1) Owner of Land: Maurie Lusia
(Name)
Bogue Chitto, Miss
(Address)

(2) Location: 1/4, 1/4, Sec. 35 T 6 R 6
7 miles North of Auburn
(distance) (direction) (Nearest Town)

(3) Topography: Hilly
(Hilly) (Flat) (Level)

(4) Purpose of Well: Domestic
(Domestic Irrigation
Municipal, Industrial, Other)

Description & Color of Materials Sand, Clay, Red Clay, Shell, etc.	Thick- ness Feet	Depth Feet
<u>Sandy Clay</u>	<u>30</u>	<u>30</u>
<u>Sand + Chalk</u>	<u>30</u>	<u>60</u>
<u>Sand + Rock</u>	<u>15</u>	<u>75</u>
<u>Sand + Chalk</u>	<u>10</u>	<u>85</u>
<u>Sand</u>	<u>10</u>	<u>95</u>

Information upon completion of well:

(1) Diameter 4" inches.

(2) Total Depth 95' feet.


(3) Water Level 65' feet below top of ground.

(4) Cased to 95', Size 4"

(5) Screen: Size 4", Length 6'

(6) Were any formations sealed against pollution?
no

CODED

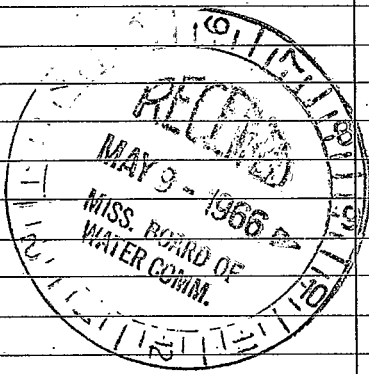

If YES depth of formation _____

Why _____

Drillers Remarks: _____

Well No.

(Use Back Side)

