

Lincoln
R5
6-68

CODED

MISSISSIPPI
 BOARD OF WATER COMMISSIONERS
 416 North State Street
 Jackson, Mississippi 39201

WATER WELL DRILLERS LOG

6-24 1968 Fidelity well Lincoln
 date well completed firm name county well located

LANDOWNER: Hurricane Lake
RR Brookhaven, Miss.
 (mailing address)

description of formations encountered	from	to
<u>Red clay</u>	<u>0</u>	<u>26</u>
<u>Red sand</u>	<u>15</u>	<u>35</u>
<u>Blue clay</u>	<u>35</u>	<u>90</u>
<u>Course sand</u>	<u>90</u>	<u>112</u>

WELL LOCATION:
 sec. 8 T 6 N R. 6 E
12 miles W of Brookhaven
 (distance) (direction) (nearest town)

WELL PURPOSE: Flow
 (home, irrigation, municipal, industrial)

- WELL COMPLETION DATA:
- (1) diameter (inches) 4
 - (2) total depth (feet) 112
 - (3) static water level (feet) 50 below above top of ground.
 - (4) casing Plastic, 106,
 (material) (depth)
4"
 (size) If telescope see back.
 - (5) screen 6 106'
 (length) (depth to top)
4 Plastic
 (size) (material)
 - (6) pump 2 2
 (HP) (yield gpm)
Electric
 (type power)
 - (7) electric log No
 (yes or no)
 (organization running log)
 - (8) how well bottom plugged wood plug


CODED

EXHIBIT B 1958
 MISS. BOARD OF
 WATER COMMISSIONERS

DRILLERS REMARKS:

If well telescopes please sketch and show depths.

GROUND LEVEL

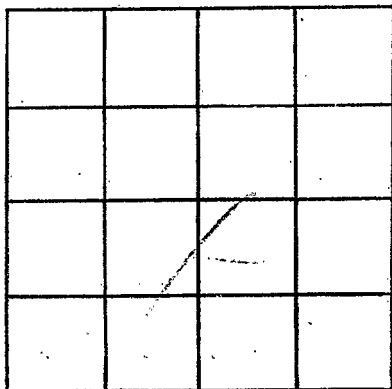

SECTION

Please indicate well location X.

ADDITIONAL INFORMATION

If more than one screen,
show locations of each on sketch.