

CODED

MISSISSIPPI
BOARD OF WATER COMMISSIONERS
416 North State Street
Jackson, Mississippi 39201

WATER WELL DRILLERS LOG

Lincoln
Kb
8-68

8-28 1968 *W. W. W. Lincoln*
date well completed firm name county well located

LANDOWNER: *Dr. M. Sisco*
Boysie Chitto Pt

description of formations encountered	from	to
<i>top soil & clay</i>	<i>0</i>	<i>26</i>
<i>sand</i>	<i>16</i>	<i>28</i>
<i>gravel</i>	<i>28</i>	<i>32</i>
<i>sand</i>	<i>82</i>	<i>100</i>
<i>gravel & sand</i>	<i>100</i>	<i>125</i>

(mailing address)


WELL LOCATION:

sec *36* T *6* N R *6* E
S W
8 miles *W* of *Boysie Chitto*
(distance) (direction) (nearest town)

WELL PURPOSE:
(home, irrigation, municipal, industrial)

WELL COMPLETION DATA:

- (1) diameter (inches) *4*
- (2) total depth (feet) *123*
- (3) static water level (feet) *65* below top of ground.
- (4) casing *plastic 1 1/2"*
(material) (depth)
- 4* if telescope see back.
(size)
- (5) screen *6'* *1 1/2"*
(length) (depth to top)
- 4* *sch 40*
(size) (material)
- (6) pump *1 gal* *10*
(GPM) (yield gpm)
- 2 hp*
(type power)
- (7) electric log *no*
(yes or no)
- (organization running log)
- (8) how well bottom plugged *plugged*

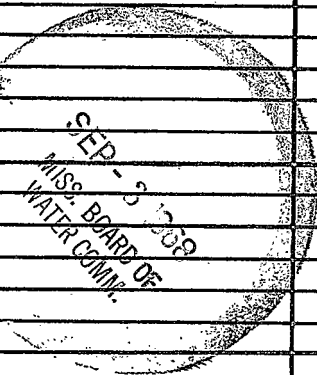

DRILLERS REMARKS:

If well telescopes please sketch and show depths.

GROUND LEVEL

X			

SECTION 35

Please indicate well location X.

ADDITIONAL INFORMATION

If more than one screen, show locations of each on sketch.