

MISSISSIPPI
BOARD OF WATER COMMISSIONERS
416 North State Street
Jackson, Mississippi 39201

CODED

WATER WELL DRILLERS LOG

Lincoln
K7
1-15-69

Jan 15 1969 Fitzgerald and Lincoln
date well completed firm name county well located

LANDOWNER:

Sam Bister
R.R. Brookdown, Miss.
(mailing address)

description of formations encountered

from to

<u>white clay</u>	<u>0</u>	<u>20</u>
<u>Blue clay</u>	<u>20</u>	<u>80</u>
<u>fine sand</u>	<u>80</u>	<u>90</u>
<u>course sand</u>	<u>90</u>	<u>100</u>

WELL LOCATION:

sec 9 T 6 N R 6 E
12 miles W. of Brookdown
(distance) (direction) (nearest town)

WELL PURPOSE:

Home
(home, irrigation, municipal, industrial)

WELL COMPLETION DATA:

- (1) diameter (inches) 4
- (2) total depth (feet) 100
- (3) static water level (feet) 38 below above top of ground.
- (4) casing Plastic 94'
(material) (depth)
4" if telescope see back.
(size)
- (5) screen 6' 94'
(length) (depth to top)
4" Plastic
(size) (material)
- (6) pump ? ?
(HP) (yield gpm)
elec
(type power)
- (7) electric log No
(yes or no)
(organization running log)
- (8) how well bottom plugged unplugged


CODED

DRILLERS REMARKS:

MISS. Bd. of
WATER COMMISSIONERS

If well telescopes please sketch and show depths.

GROUND LEVEL

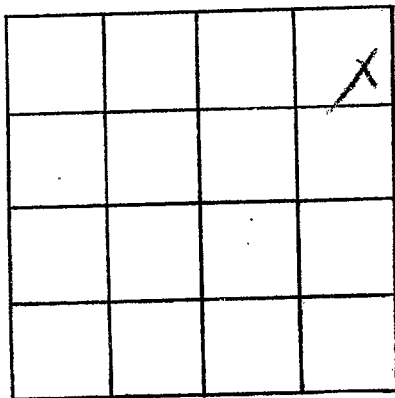

SECTION 9

Please indicate well location X.

ADDITIONAL INFORMATION

If more than one screen, show locations of each on sketch.