

MISSISSIPPI  
BOARD OF WATER COMMISSIONERS  
416 North State Street  
Jackson, Mississippi 39201

DEC 6 1971

WATER WELL DRILLERS LOG

**CODED**

LINCOLN  
K 10  
10-11-71

11 Oct  
date well completed

1971

J. T. Co. Inc.  
firm name

Lincoln  
county well located

LANDOWNER:  
Jubran Co. Inc.  
M<sup>o</sup> Creek  
(mailing address)

description of formations encountered	from	to
Clay	0	15
Sandstone	15	35
Chalk	35	55
Sandstone	55	85
Chalk sand	85	95
Sand	95	113

WELL LOCATION:  
sec. 4 T. 6 N. R. 4 E  
8 miles West of Broadway  
(distance) (direction) (nearest town)

WELL PURPOSE: camp  
(home, irrigation, municipal, industrial)

WELL COMPLETION DATA:  
(1) diameter (inches) 4  
(2) total depth (feet) 113  
(3) static water level (feet) 70 below above top of ground.  
(4) casing PI 107  
(material) (depth)  
(size) if telescope see back.  
(5) screen 6 107  
(length) (depth to top)  
14 PI  
(size) (material)  
(6) pump 1/2 8  
(HP) (yield gpm)  
Electric  
(type power)  
(7) electric log (yes or no)


**CODED**

(organization running log)  
(8) how well bottom plugged Wood

DRILLERS REMARKS:

If well telescopes please sketch and show depths.

GROUND LEVEL

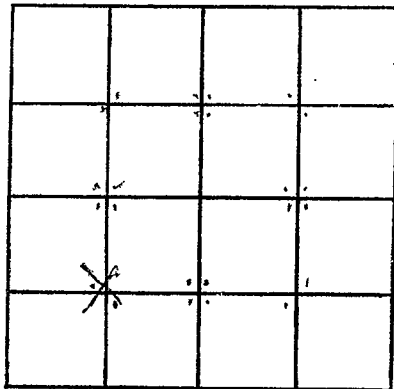

SECTION 2

Please indicate well location X.

ADDITIONAL INFORMATION

If more than one screen,  
show locations of each on sketch.