

MISSISSIPPI  
BOARD OF WATER COMMISSIONERS  
416 North State Street  
Jackson, Mississippi 39201

WATER WELL DRILLERS LOG

**CODED**

LINCOLN  
K 11  
11-17-71

17 Nov 1971  
date well completed

24 Water Well  
firm name

Lincoln  
county well located

LANDOWNER:

W. L. Sore

M. C. Comb, Miss  
(mailing address)

WELL LOCATION:

sec. 4 T. 6 N. S. R. 6 E.  
8 miles W of Bradley  
(distance) (direction) (nearest town)

WELL PURPOSE:

(home, irrigation, municipal, industrial)

WELL COMPLETION DATA:

- (1) diameter (inches) 4
- (2) total depth (feet) 110
- (3) static water level (feet) 65 below above top of ground.
- (4) casing 01 104  
(material) (depth)
- (size) if telescope see back.
- (5) screen 6 104  
(length) (depth to top)
- 4 (size) (material)
- (6) pump 1/2 8  
(HP) (yield gpm)
- shot (type power)
- (7) electric log (yes or no)

(organization running log)

(8) how well bottom plugged wood

description of formations encountered

from to

<u>Clay shale</u>	<u>0</u>	<u>12</u>
<u>Shale</u>	<u>10</u>	<u>30</u>
<u>Clay</u>	<u>30</u>	<u>60</u>
<u>Chalk</u>	<u>60</u>	<u>80</u>
<u>Sand</u>	<u>80</u>	<u>110</u>

**CODED**


JAN 12 1972

DRILLERS REMARKS:

MISS OF  
WATE

If well telescopes please sketch and show depths.

GROUND LEVEL

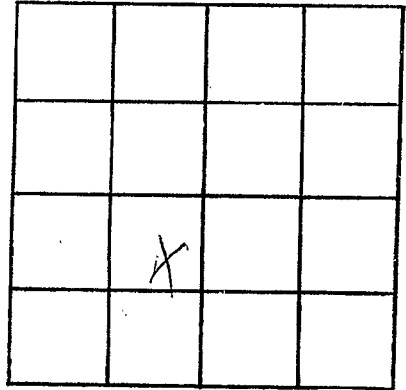

SECTION 4

Please indicate well location X.

ADDITIONAL INFORMATION

If more than one screen, show locations of each on sketch.