

LINCOLN  
K12  
6-5-72

MISSISSIPPI  
 BOARD OF WATER COMMISSIONERS  
 416 North State Street  
 Jackson, Mississippi 39201

WATER WELL DRILLERS LOG

**CODED**

June 5 1972 Grenn Water Well Contractor  
 date well completed firm name county well located

LANDOWNER:	description of formations encountered	from	to
W. C. Wallace			
Route 5, Box 135	clay, sand an gravel	0	30
Brookhaven, Miss.	clay	30	120
(mailing address)	sand	120	141
WELL LOCATION:	clay	141	165
sec. <u>4</u> T <u>6</u> N R <u>6</u> E			
<u>11</u> miles <u>W</u> of <u>Brookhaven</u>			
(distance) (direction) (nearest town)			
WELL PURPOSE: <u>home</u>			
(home, irrigation, municipal, industrial)			
WELL COMPLETION DATA:			
(1) diameter (inches) <u>6"</u>			
(2) total depth (feet) <u>165</u>			
(3) static water level (feet) <u>100</u> below above top of ground.			
(4) casing <u>PVC</u> <u>134</u>			
(material) (depth)			
<u>4"</u> if telescope see back.			
(size)			
(5) screen <u>6'</u> <u>134</u>			
(length) (depth to top)			
<u>.010</u> <u>PVC</u>			
(size) (material)			
(6) pump <u>1/2 HP. Sub.</u> <u>7</u>			
(HP) (yield gpm)			
<u>electric</u>			
(type power)			
(7) electric log <u>no</u>			
(yes or no)			
(organization running log)			
(8) how well bottom plugged <u>wood</u>			
DRILLERS REMARKS:			

**CODED**


ISSUED 2.8 1972

MISSISSIPPI

If well telescopes please sketch and show depths.

GROUND LEVEL

I

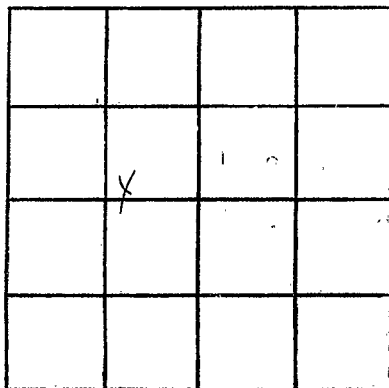

SECTION 44

Please indicate well location X.

ADDITIONAL INFORMATION

If more than one screen,  
show locations of each on sketch.