

LINCOLN
K 14
7-17-73

MISSISSIPPI
BOARD OF WATER COMMISSIONERS
416 North State Street
Jackson, Mississippi 39201

CODED 1973

MISS. BD. OF
WATER COMM.

WATER WELL DRILLERS LOG

17 July 1973 Amos K. K. Wells Lincoln
date well completed firm name county well located

LANDOWNER:

Riley Touchstone
McCall Creek
(mailing address)

description of formations encountered

from

to

clay dirt	0	55
Pea gravel + sand	55	59
chalk	59	185
Pea gravel + sand	185	222

WELL LOCATION:

sec 22 T 6 N R 6 E
3 miles W of W. Lincoln
(distance) (direction) (nearest town)

WELL PURPOSE:

(home, irrigation, municipal, industrial)

WELL COMPLETION DATA:

- (1) diameter (inches) 4
- (2) total depth (feet) 222
- (3) static water level (feet) 110 below above top of ground.
- (4) casing PI 216
(material) (depth)
if telescope see back.
(size)
- (5) screen 6 216
(length) (depth to top)
6 PI
(size) (material)
- (6) pump 1/2 8
(HP) (yield gpm)
Plot
(type power)
- (7) electric log _____
(yes or no)

(organization running log)


(8) how well bottom plugged wood

CODED

DRILLERS REMARKS:

If well telescopes please sketch and show depths.

GROUND LEVEL

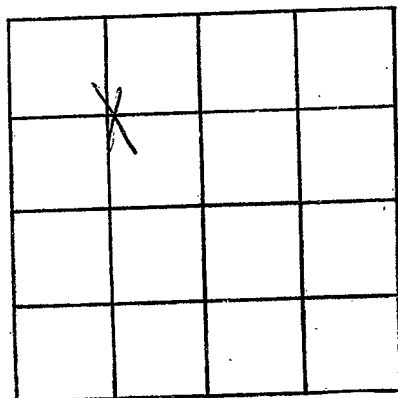

SECTION 22

Please indicate well location X.

ADDITIONAL INFORMATION

If more than one screen, show locations of each on sketch.