

LINCOLN  
 K 15  
 10-11-73

MISSISSIPPI  
 BOARD OF WATER COMMISSIONERS  
 416 North State Street  
 Jackson, Mississippi 39201

CODED

WATER WELL DRILLERS LOG

Oct-11 1973 Brennwater Well Co. Lincoln  
 date well completed firm name county well located

LANDOWNER: Harry Myers  
Boguer Chitts, Miss.  
 (mailing address)

description of formations encountered	from	to
	<u>Citronelle</u>	<u>0</u>

WELL LOCATION:  
 sec. 24 T. 6 N. R. 6 E.  
10 miles S.W. of Broadhaven  
 (distance) (direction) (nearest town)

WELL PURPOSE: home  
 (home, irrigation, municipal, industrial)

- WELL COMPLETION DATA:
- (1) diameter (inches) 6"
  - (2) total depth (feet) 25
  - (3) static water level (feet) 11 below above top of ground.
  - (4) casing PVC, 19,  
 (material) (depth)  
4 if telescope see back.  
 (size)
  - (5) screen 6, 19  
 (length) (depth to top)  
.010, PVC  
 (size) (material)
  - (6) pump did not  
 (HP) (yield gpm)  
install  
 (type power)
  - (7) electric log no  
 (yes or no)  
 (organization running log)
  - (8) how well bottom plugged wood


CODED

DRILLERS REMARKS:

OCT 25 1973

If well telescopes please sketch and show depths.

GROUND LEVEL

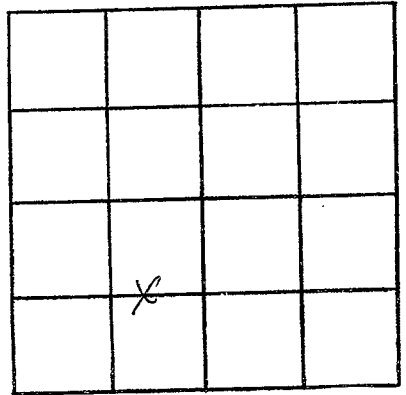

SECTION 24

Please indicate well location X.

ADDITIONAL INFORMATION

If more than one screen, show locations of each on sketch.